


T.9S.,R.5W.,W.M.

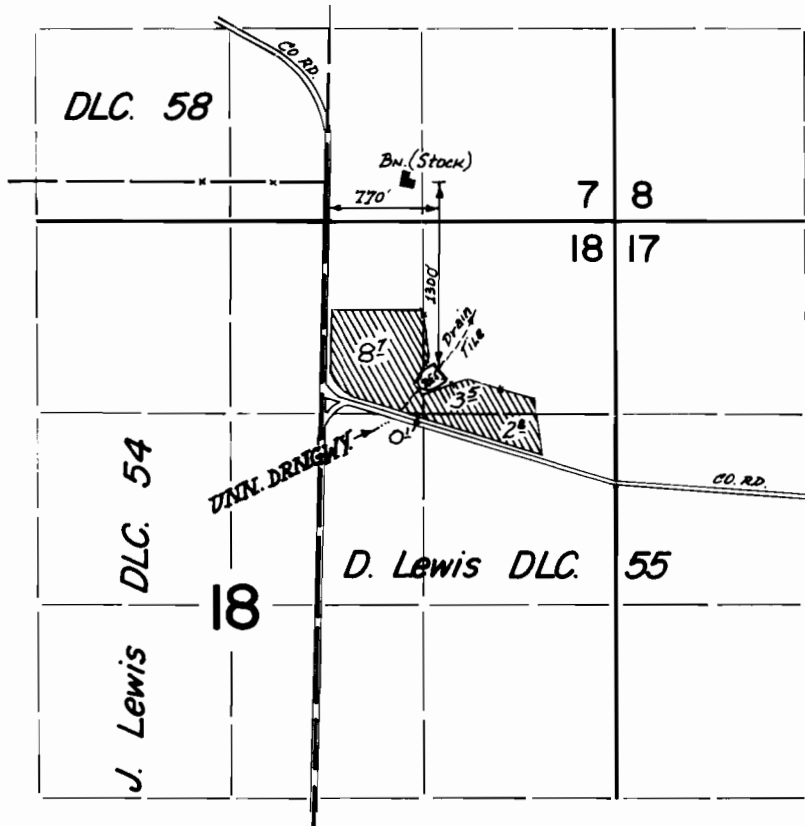

FINAL PROOF SURVEY
UNDER

R-48850 R-5928
Application No. 48851 Permit No. 36606
IN NAME OF

VERN RATZLAFF

Surveyed *JULY 5* 1977, by *L.M. Toll*