T.9S., R.5W., W.M.

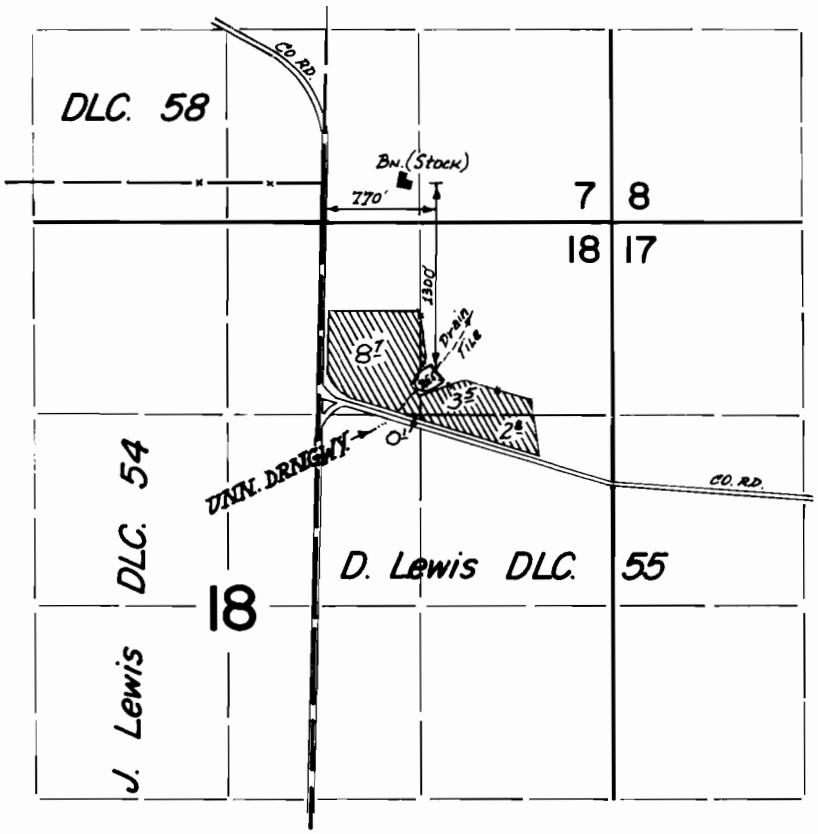

FINAL PROOF SURVEY

UNDER

R-48850 R-5928

Application No. 48851 Permit No. 36606

IN NAME OF

VERN RATZLAFF

Surveyed JULY 5 1977, by L.M. TOLL

DFP-ILL-94 & 1977-U