


T.2S.R.2W.W.M.

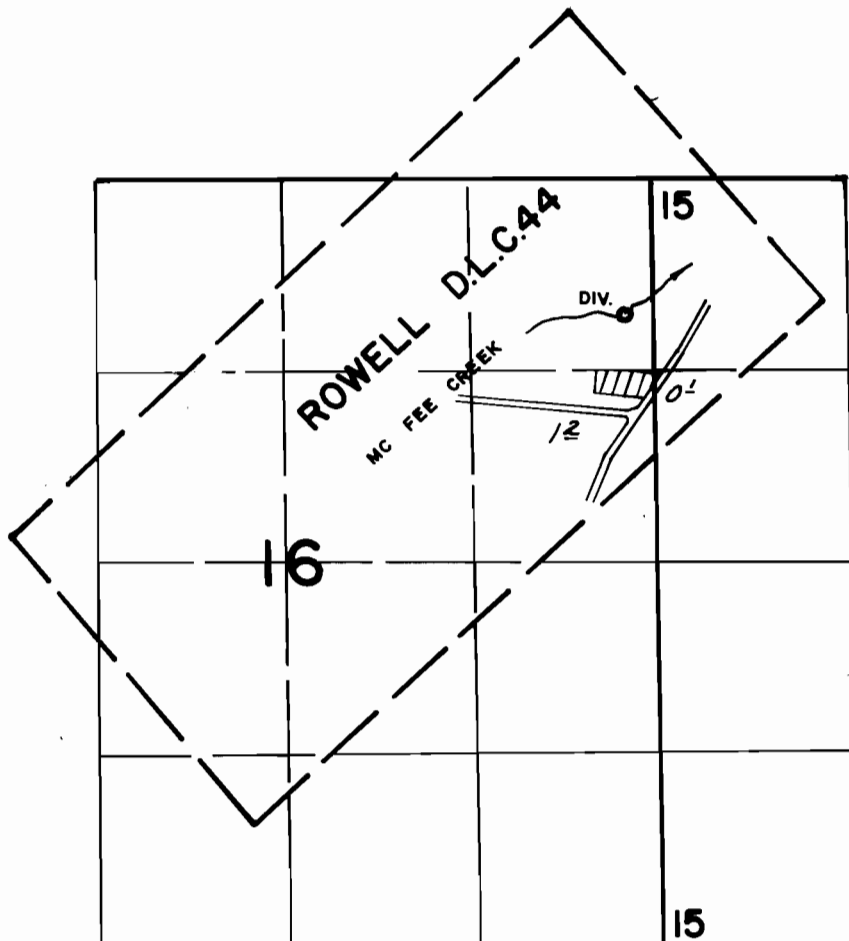

DIV. LOC: 930' S. & 190 W. FROM N.E. COR. SEC. 16

FINAL PROOF SURVEY
UNDER

Application No. 55169 Permit No. 41463
IN NAME OF

DONALD L. HAYNES

Surveyed JUNE 23 1978, by S.P. APPELEGATE