


T.1N.R.48E.W.M.

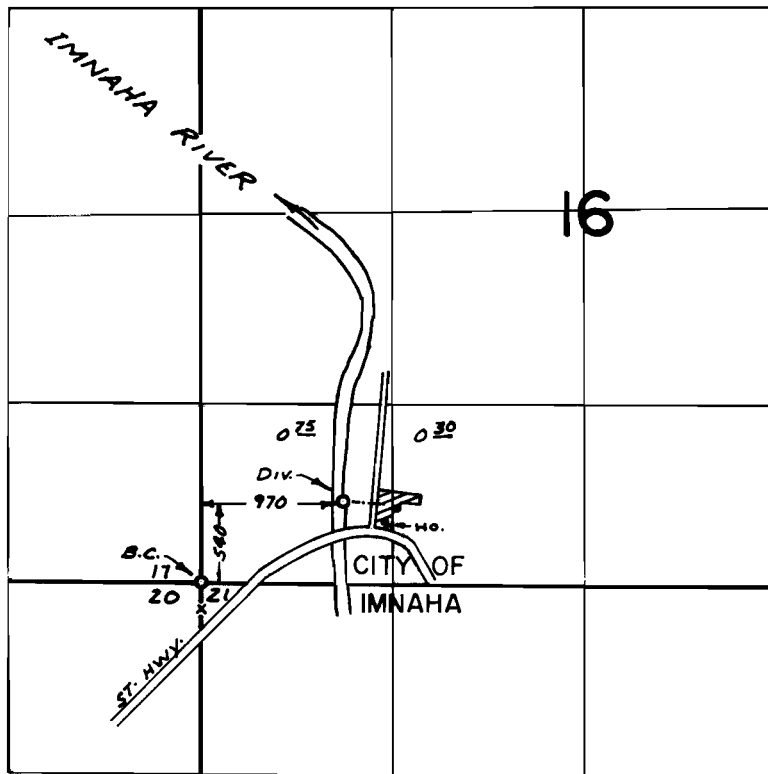

FINAL PROOF SURVEY UNDER

Application No. 48132..... Permit No. 36140.....
IN NAME OF

.....JOHN BALES.....

Surveyed SEPT. 24, 1976., by R. MUCKEN..