


RECORDED
DEC 31 1978
LULLY

T.1S.,R.13E.,W.M.

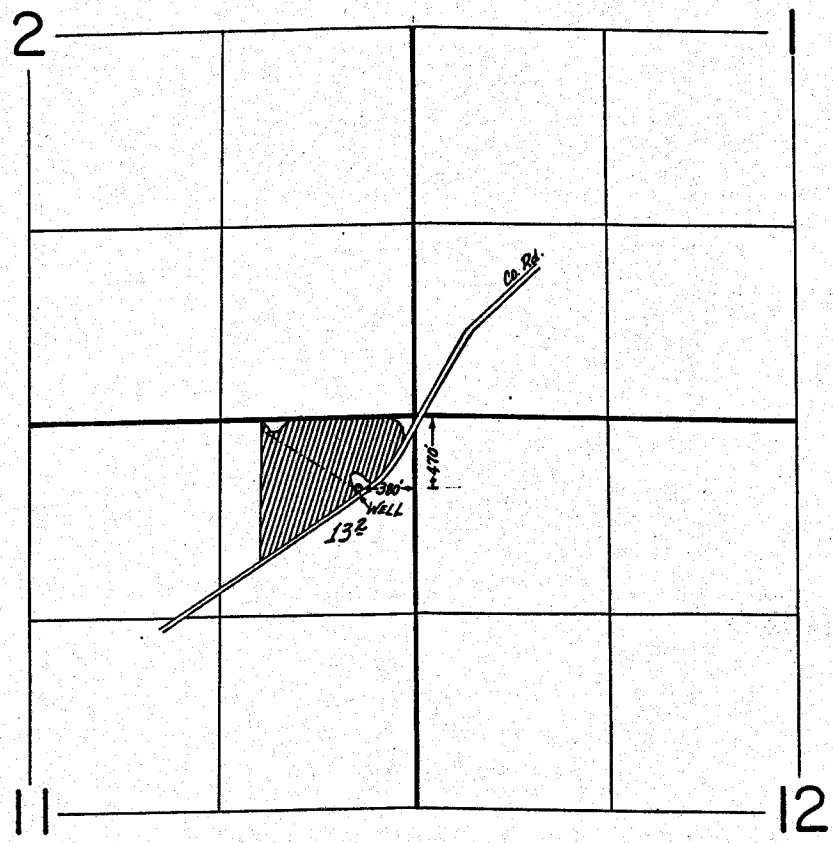

FINAL PROOF SURVEY
UNDER

Application No. G-6034 Permit No. G-5751
IN NAME OF

BRIAN BROGAN

Surveyed April 26 1978, by *St. Applegate*