

RECEIVED

APR 25 1977

RECEIVED

WATER RESOURCES DEPT.

JUL 13 1977

OREGON

WATER RESOURCES DEPT.


ORCHARDS

290
56.95 Ac.

Application No. G-8066
Permit No. G 7467

29-5

DALLEY - CALIFORNIA

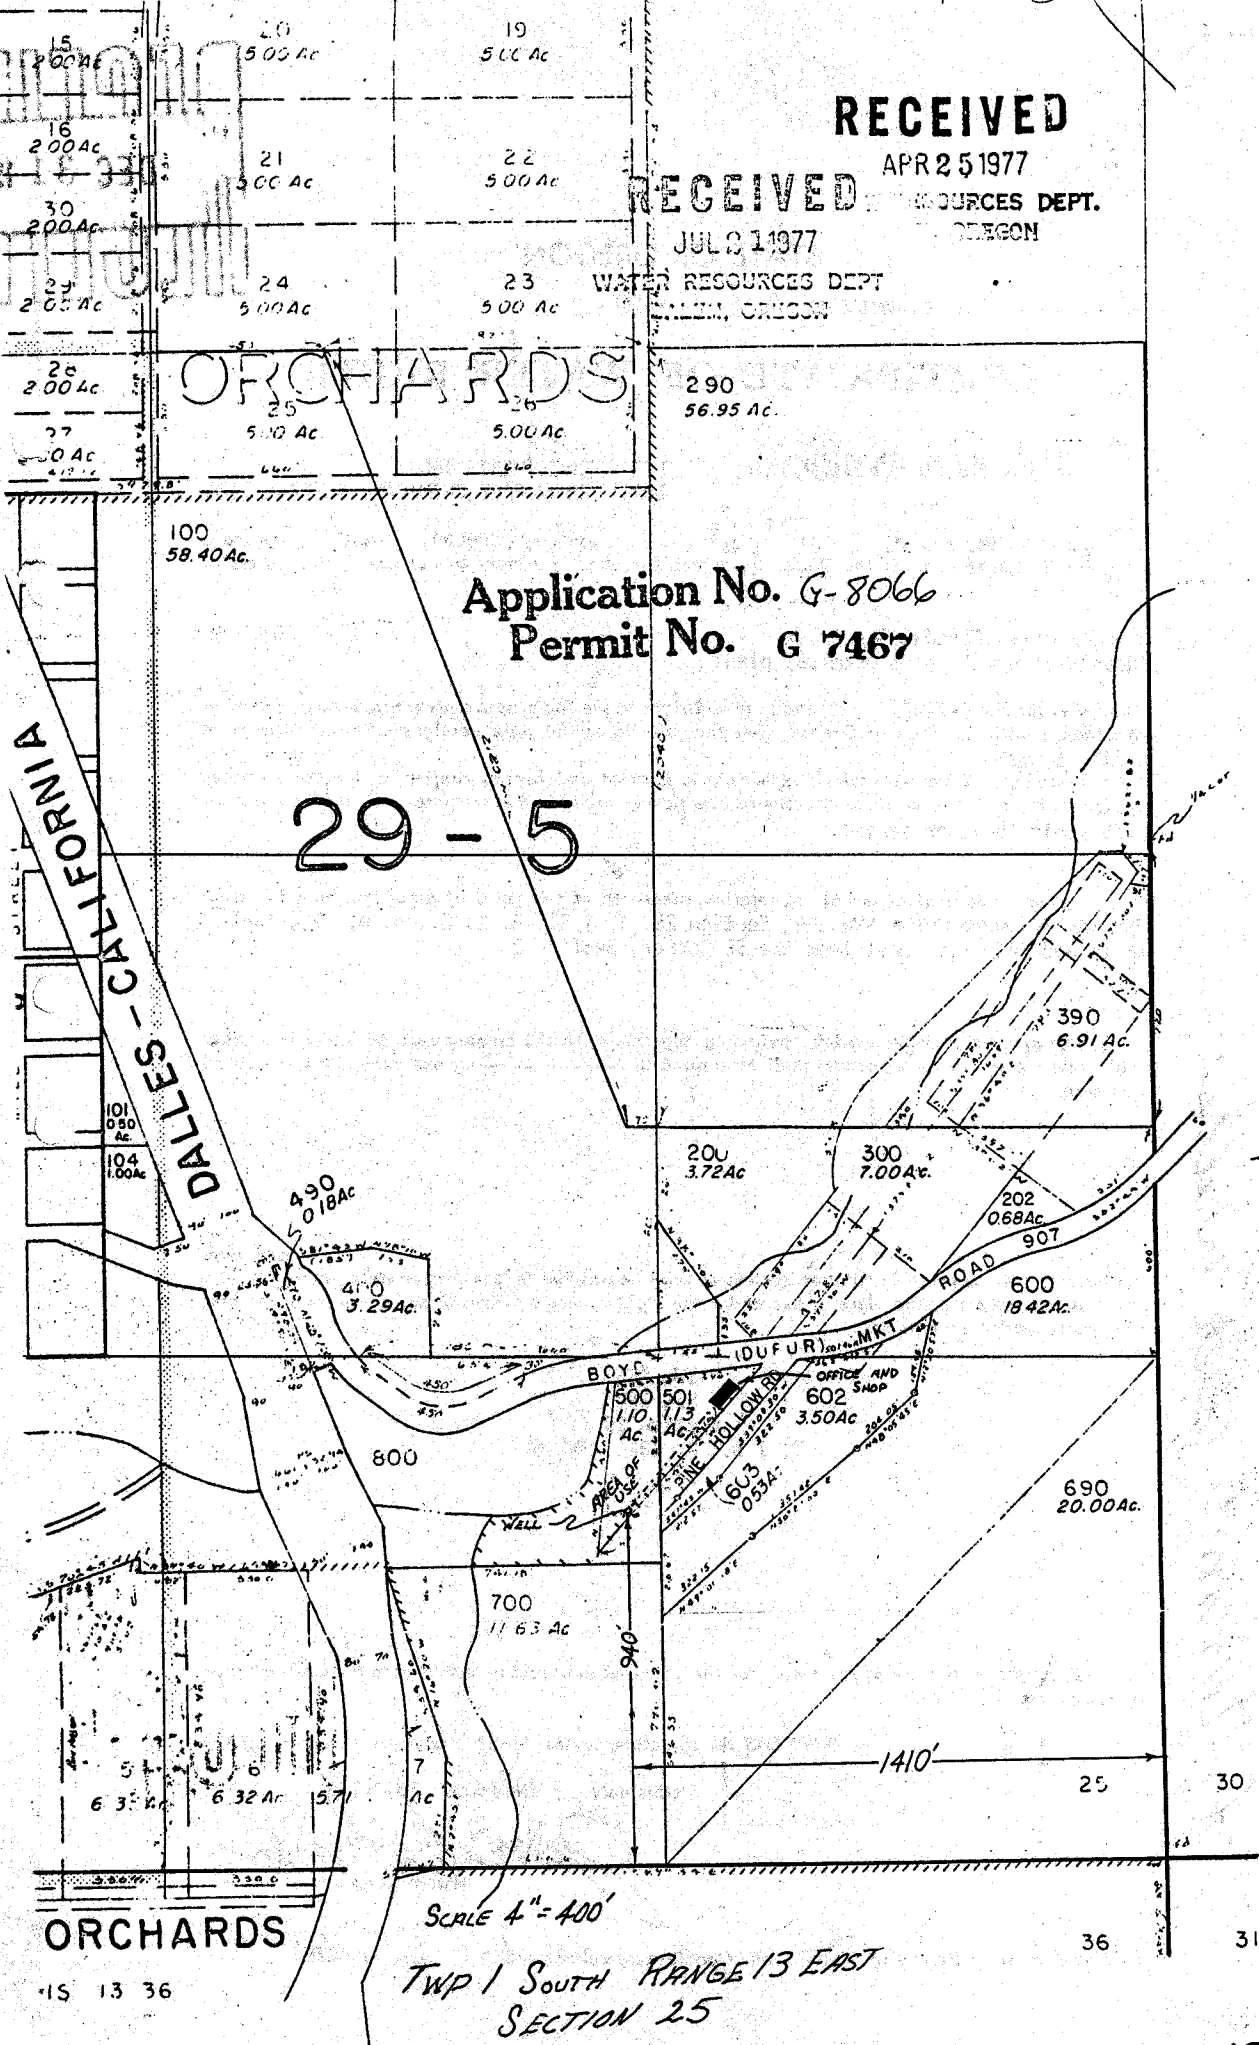

ORCHARDS

15 13 36

15

JUL 2 1977

OREGON


WATER RESOURCES DEPT

ORCHARDS

Application No. G-8066
Permit No. G 7467

29-5

DALES - CALIFORNIA

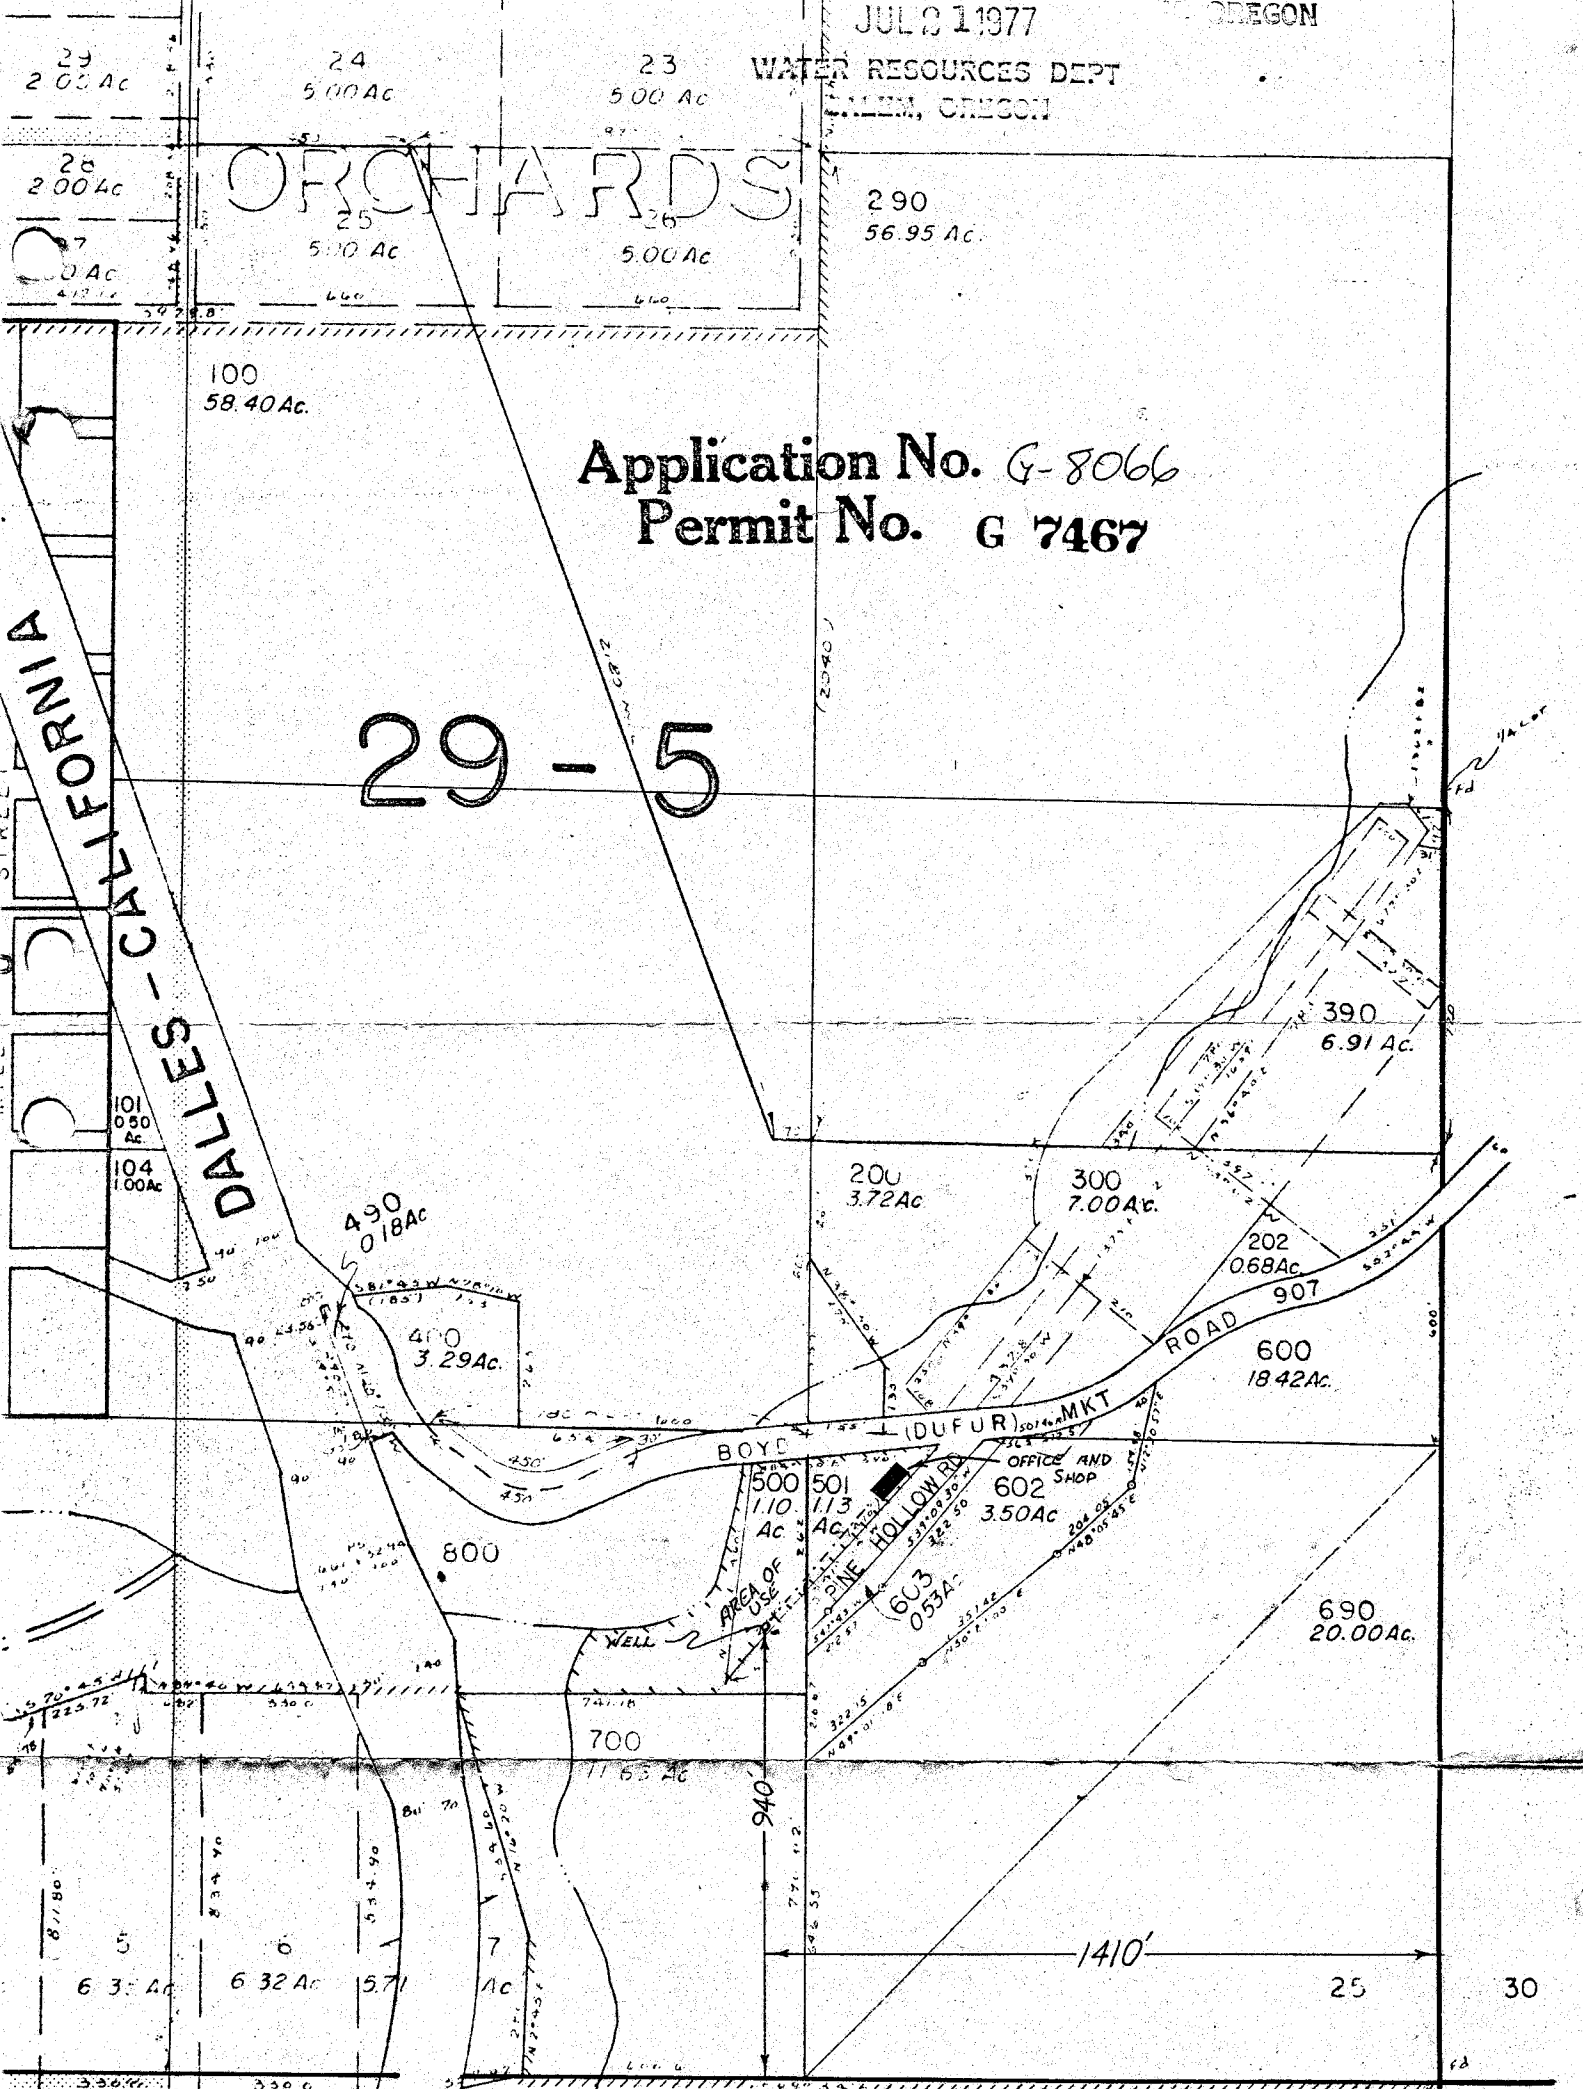

ORCHARDS

SCALE 4" = 400'

TWP 1 S. R. 13 E.