


T.I.S., R.14E., W.M.

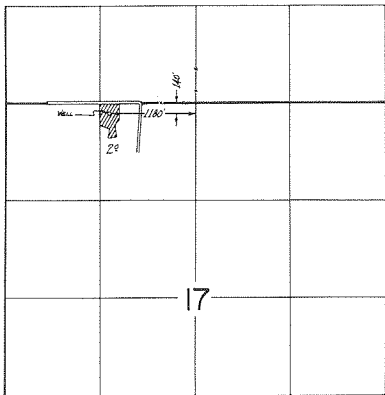

**FINAL PROOF SURVEY**  
UNDER

Application No. G-8453 Permit No. G-7598  
IN NAME OF

LEO & ELLEN SCHINDLER

Surveyed April 27 1978 by *Dr. Applegate*

RECEIVED  
DEC 31 1978  
1978