


40467

RECEIVED
DEC 31 1979

T.3S.,R.12E.,WM.

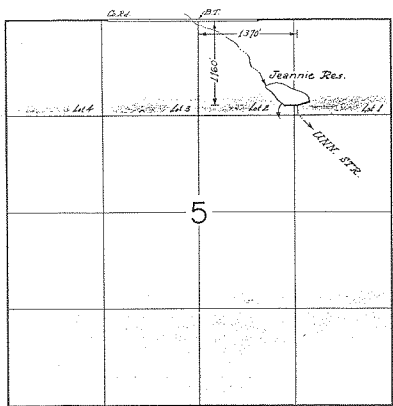

FINAL PROOF SURVEY
UNDER

R-53954 R-6449
Application No. 53955 Permit No. 40467...
IN NAME OF

ORE. DEPT. of FISH & WILDLIFE

Surveyed April 21, 1978, by *W. Applgate*