


40467

2581 E 030

DEC 31 1979

T.3S.,R.12E.,W.M.

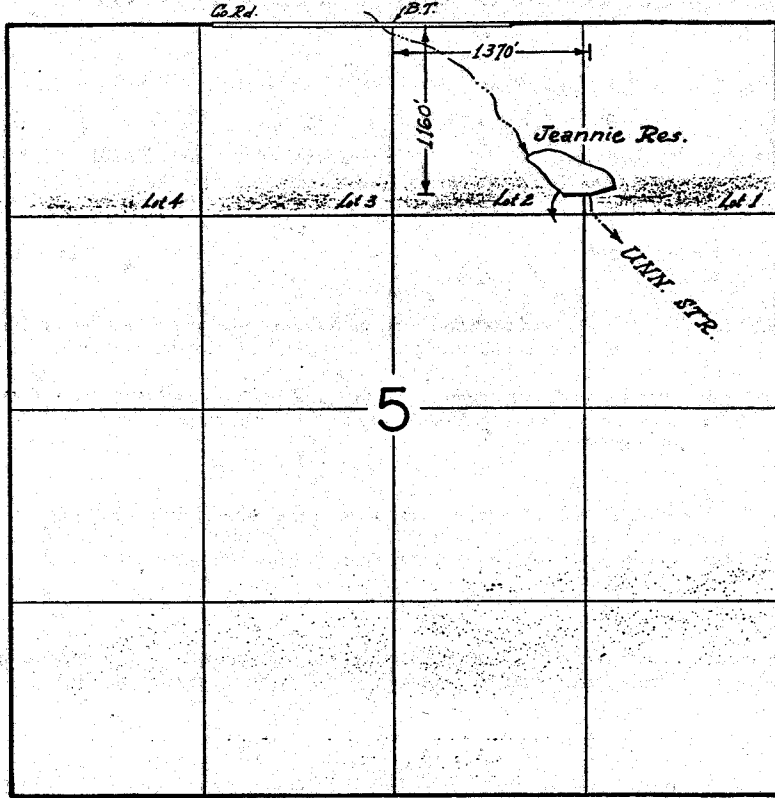

FINAL PROOF SURVEY UNDER

R-53954 R-6449 Application No. 53955 Permit No. 40467... IN NAME OF

ORE. DEPT. of FISH & WILDLIFE

Surveyed April 27 1978, by S.B. Applegate