


T. 2N., R. 12E., W.M.

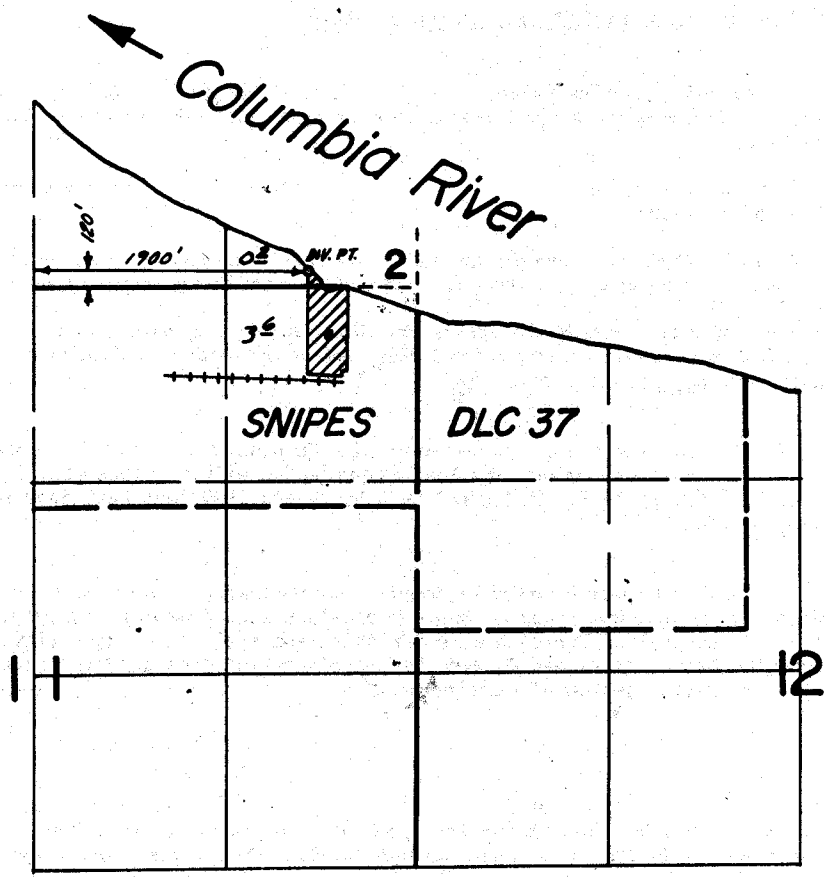

FINAL PROOF SURVEY UNDER

Application No. 55179 Permit No. 41352

IN NAME OF

Harold K. Davis

Surveyed Mar. 30, 1978, by L. Nunn

