


RECEIVED  
DEC 31 1979  
REGISTERED

T.4S.,R.12E.,W.M.

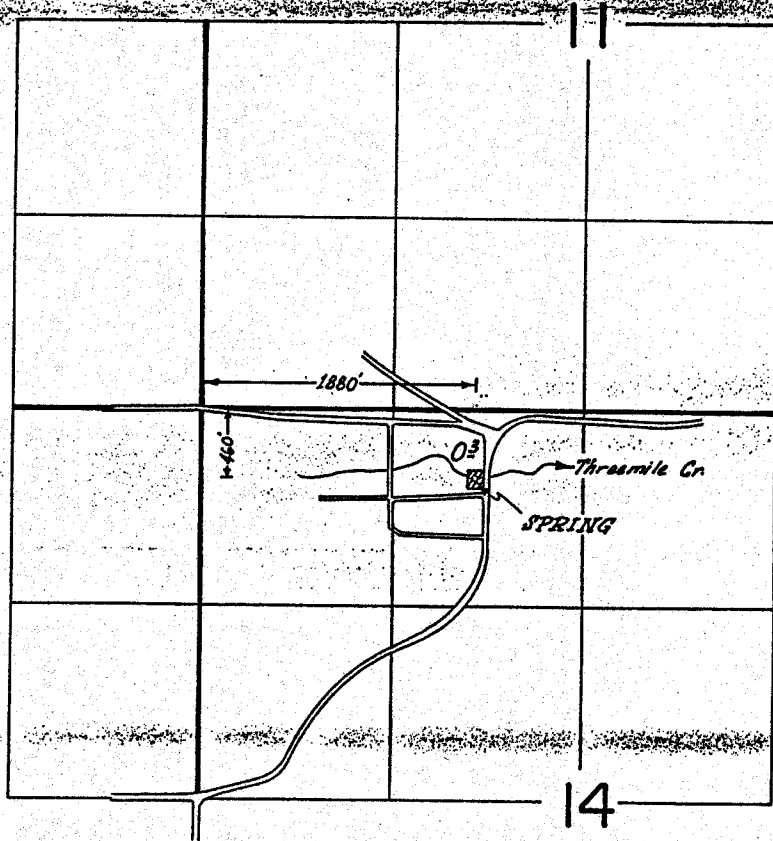

**FINAL PROOF SURVEY**  
UNDER

Application No. 55833..... Permit No. 41890.....  
IN NAME OF

R. N. McLAURIN

Surveyed *April 25* 19*78*, by *SB Appligate*