


Application No. 56514
Permit No. 42414

T. 1N, R. 12E
SEC 22
SW 1/4 SW 1/4
Scale 1" = 100'

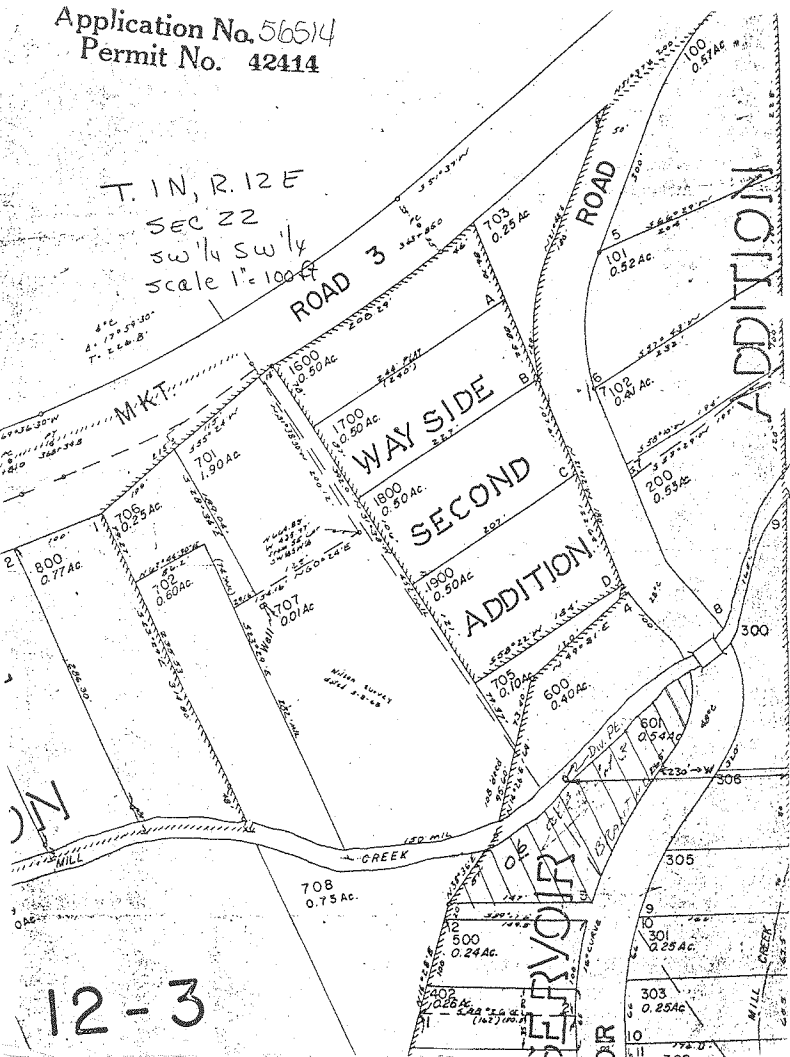

12-3