


T.3S.,R.2W.,W.M.

Section 7

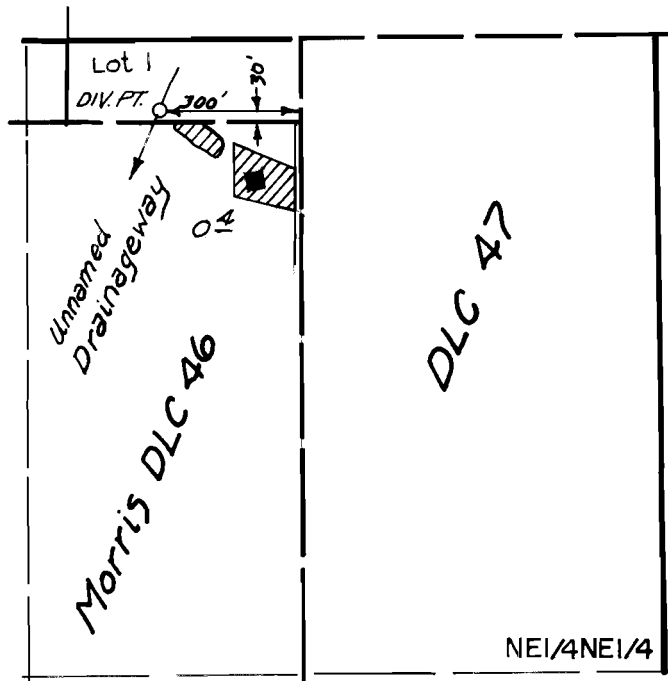

SCALE 1" = 400'

FINAL PROOF SURVEY
UNDER

Application No. 53484 Permit No. 39787

IN NAME OF

Forrest M. Gist

Surveyed May 2, 1978, by L. Nunn