
T. 8S. R. 39E.W.M.

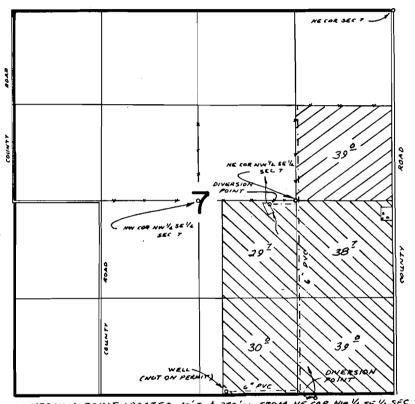

DIVERSION POINT LOCATED 40'S. & 3TO W. FROM NE COR NW 1/4 SE 1/4 SEC 7 DIVERSION POINT LOCATED 50'S. & 1110'W. FROM SE COR SEC 7





FINAL PROOF SURVEY

UNDER

53003

40307

R53I64

R6424

Application No. .50401.... Permit No. .39119......

IN NAME OF

THOMAS L.& JEAN B. GRIFFITH

Surveyed OCT 26 19 77, by R. BARWIN