


T. 12S. R. 6W. W.M.

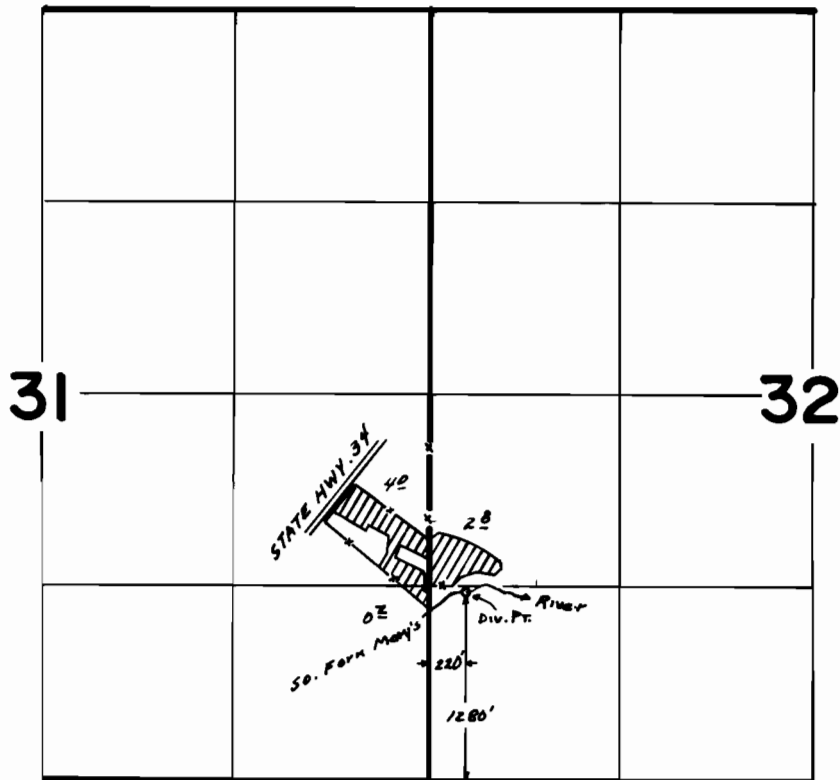

FINAL PROOF SURVEY UNDER

Application No. 49786... Permit No. 37455...
IN NAME OF

.....JOHN S. JACKIMIEC.....

Surveyed April 13, 1978., by J.S. Donaldson...