
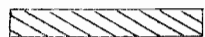


RECEIVED


JAN 16 1966

STATE ENGINEER
SALEM OREGON

T.17S.R.21E. W.M.

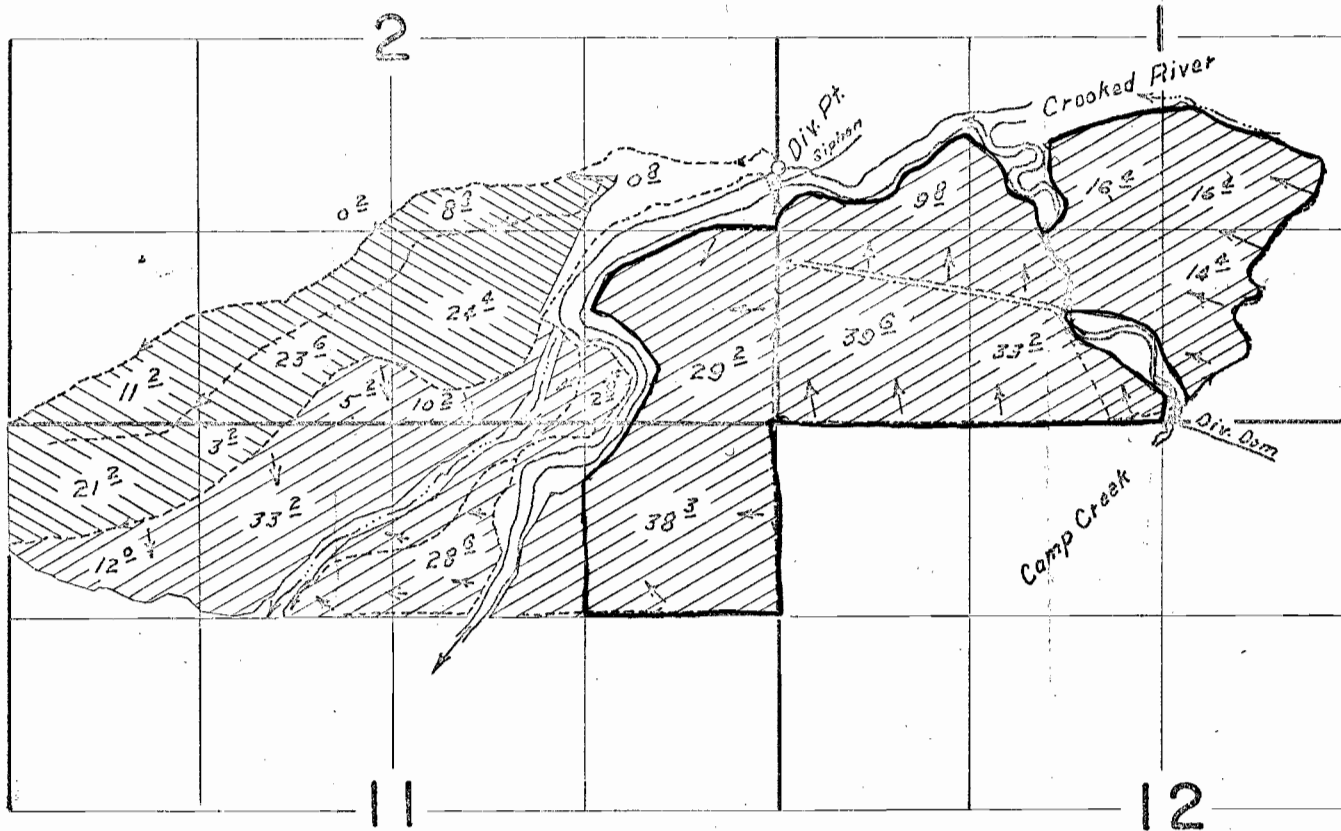

Permit No. 26390

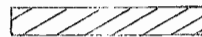

Permit No. 22142

FINAL PROOF SURVEY
UNDER

Application Nos. 28130, 33409 Permit Nos. 22142, 26390

IN NAME OF
GALE MERWIN

Surveyed Sept. 29, 30, 1964 By R. Jackson