


T.17S. R.21E. W.M.

RECEIVED  
JAN 21 1980

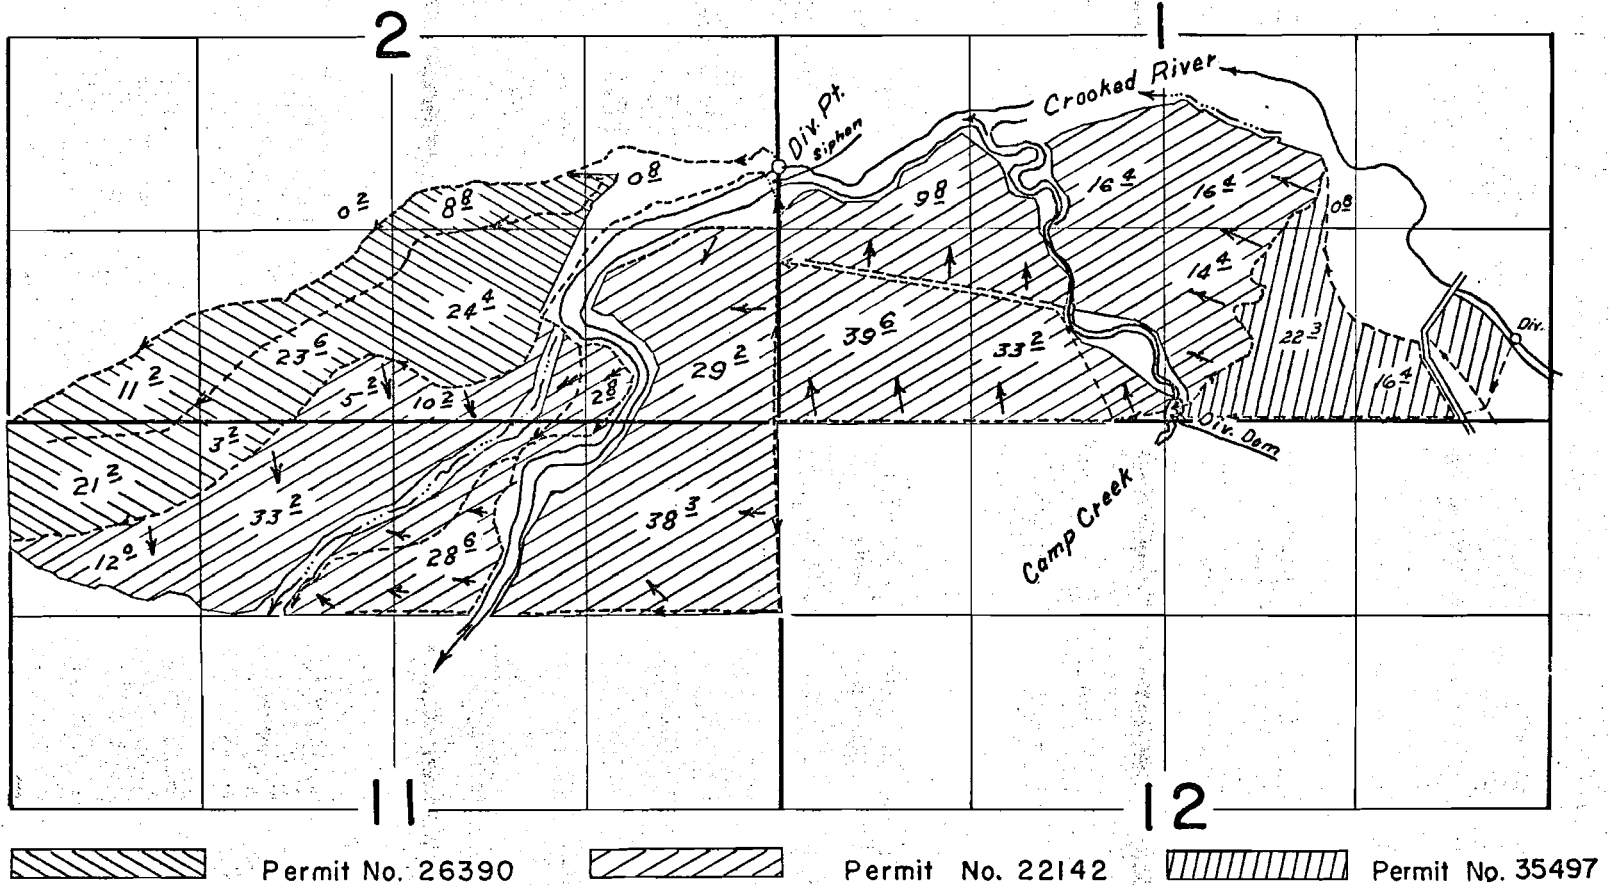

FINAL PROOF SURVEY  
UNDER

Application Nos. 47742, 28130, 33409 Permit Nos. 35497, 22142, 26390

IN NAME OF

GALE MERWIN

Aug. 4, 1977 D. NORBY  
Surveyed Sept. 29, 30, 1964 By: R. Jackson

35497

048787

35497  
1964-F; 1975-B