


T. 26 S., R. 7 W., W.M.

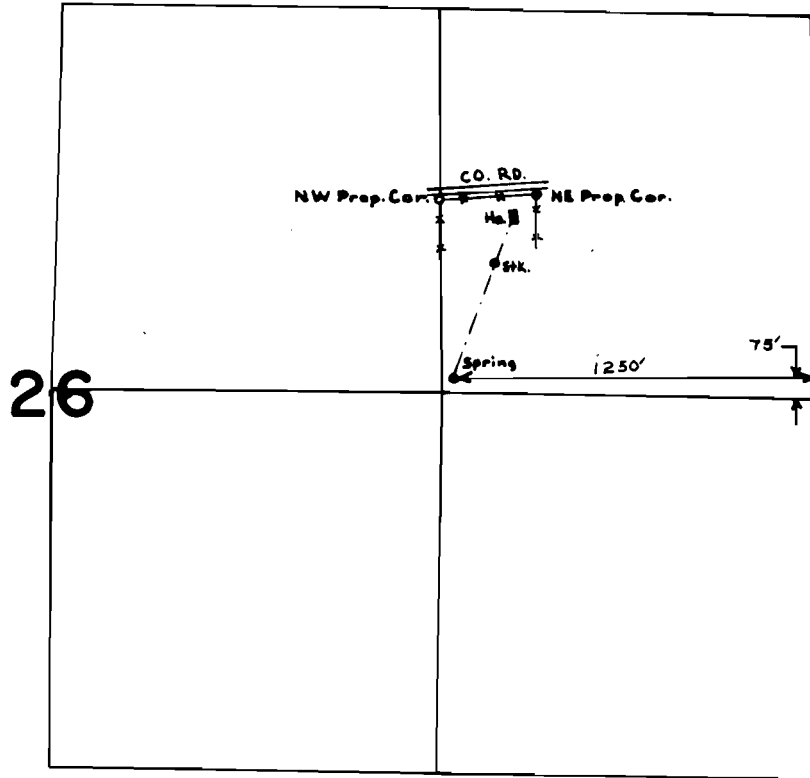

SCALE: 1" = 660'

FINAL PROOF SURVEY
UNDER

Application No. 55173 Permit No. 41465
IN NAME OF

CHARLES & WILMA MICAN

Surveyed APR. 10. 1978, by D.W. SPARKS