


T. 23 & 24 S., R. 5 & 4 W., W.M.

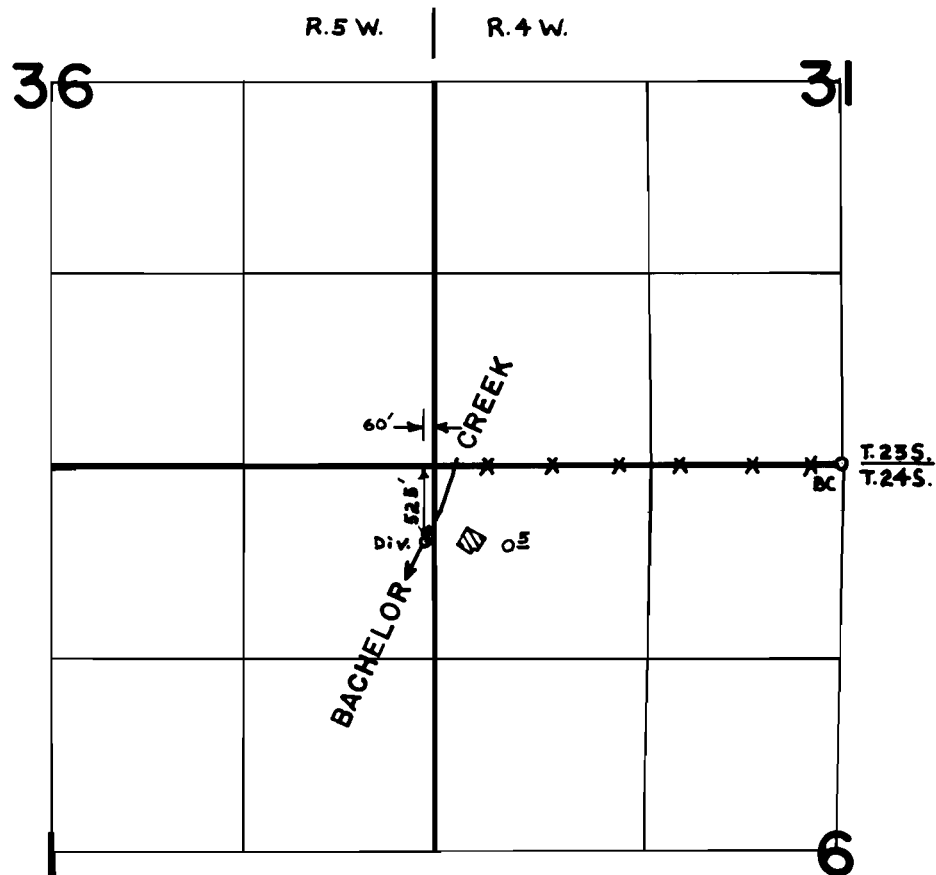

FINAL PROOF SURVEY
UNDER

Application No. 54828 Permit No. 41132
IN NAME OF

ARCHIE McCULLOUGH

Surveyed JUNE 1 1978, by D.W. SPARKS