


T. 26 S., R. 3 W., W.M.

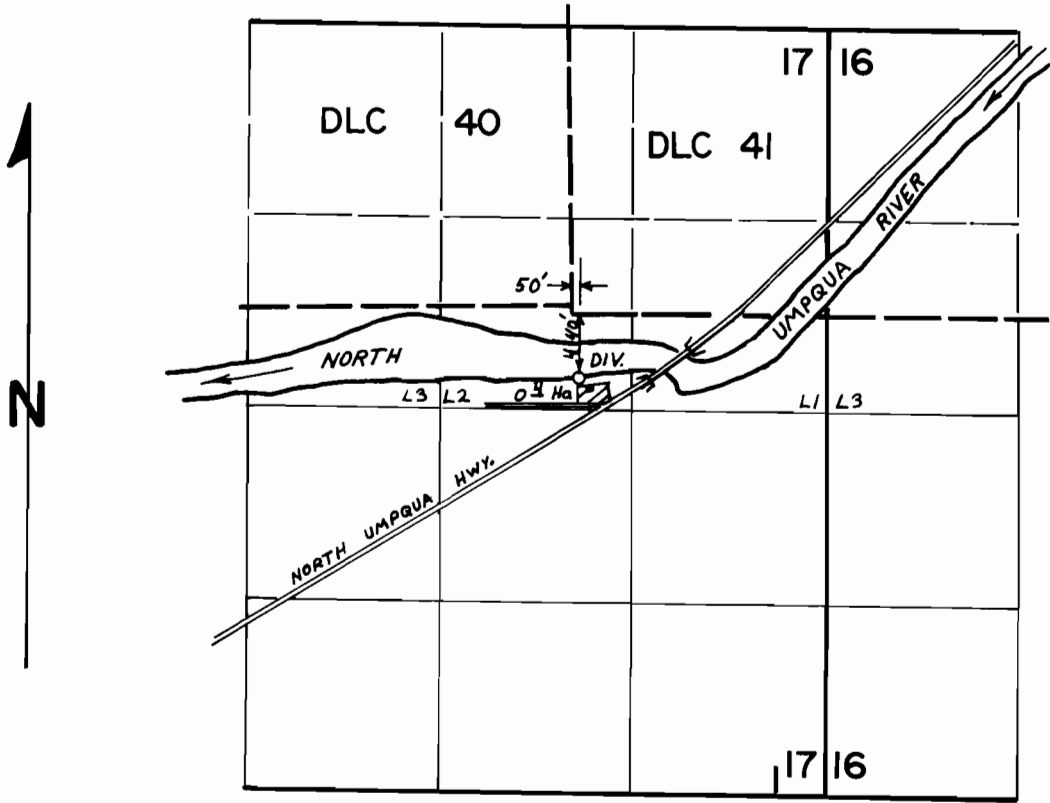

SCALE: 4" = 1 mile

**FINAL PROOF SURVEY**  
UNDER

Application No. 54.8.6.4 Permit No. 411.5.4.....  
IN NAME OF

.....**LEO F. WYNDEARO**.....

Surveyed AUG...30 19..84, by *L.F. Cashion*.....