


T.30S. R.2W. W.M.

29|28
32|33

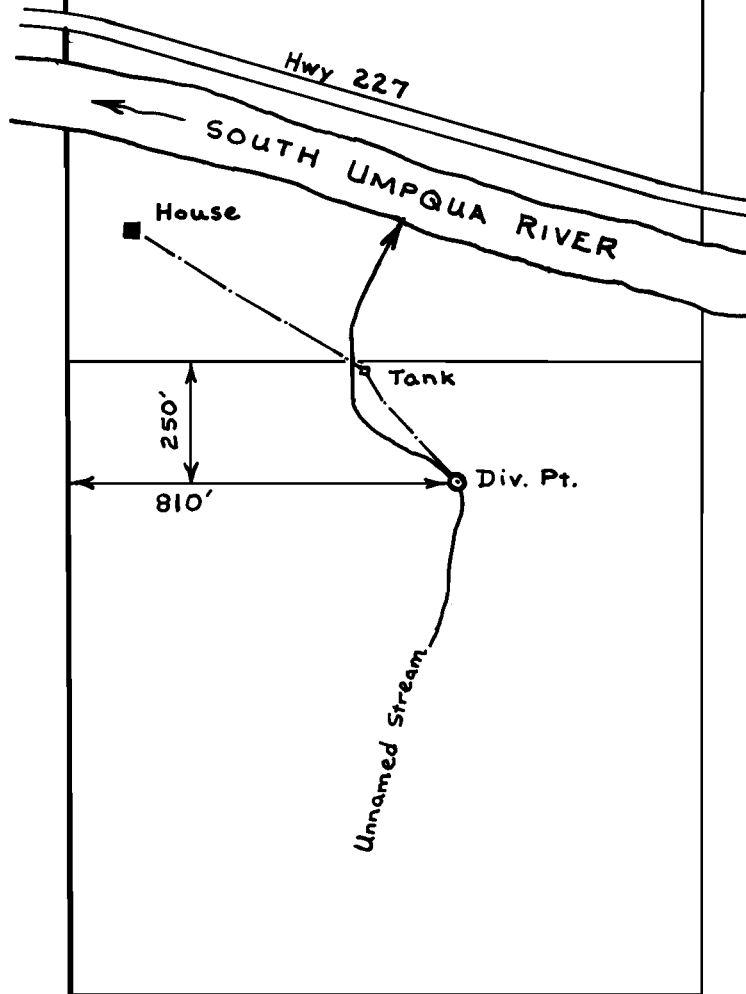

SCALE: 1" = 400'

FINAL PROOF SURVEY
UNDER

Application No. 51285 Permit No. 38729
IN NAME OF
JAMES GORDON HUNT

Surveyed Sept. 14, 1978, by D. Henry