


T.29S. R.4W. W.M.

Sec. 14

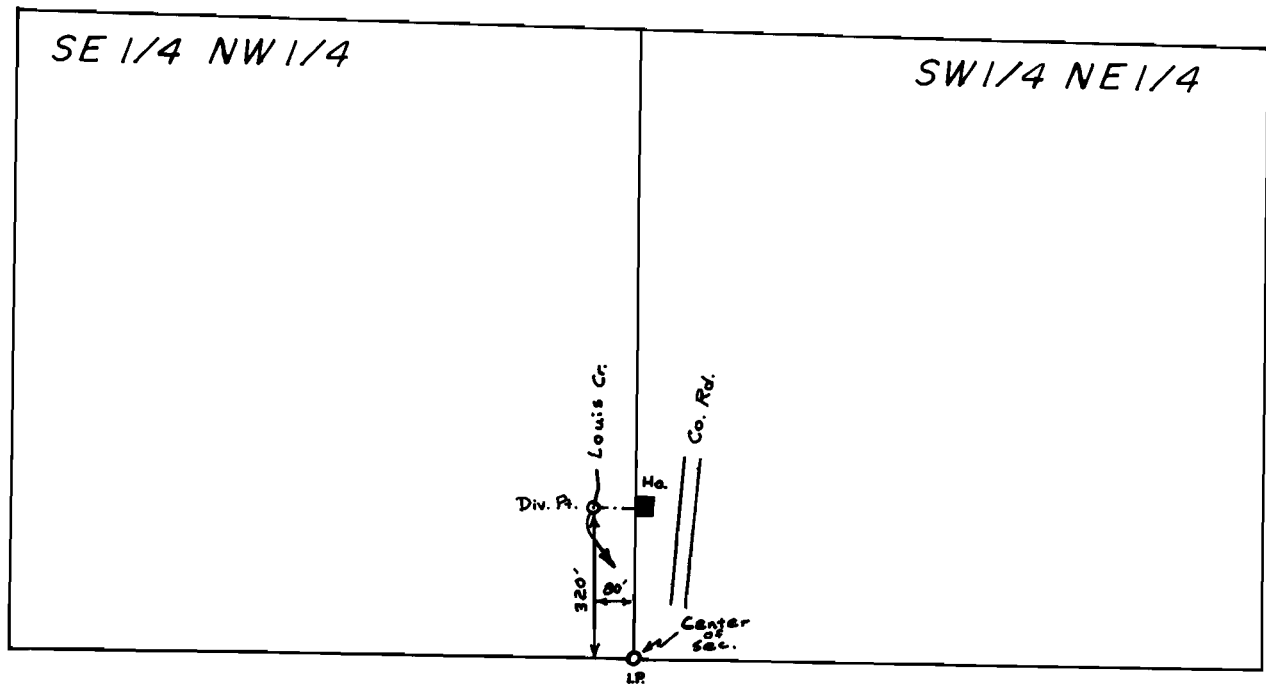

SCALE : 1" = 400'

FINAL PROOF SURVEY
UNDER

Application No. 54113 Permit No. 40509
IN NAME OF

FRANCIS J. SCHREIBER

Surveyed Nov. 8 1978, by S. Donaldson