


T. 26 S. R. 6 W. W.M.

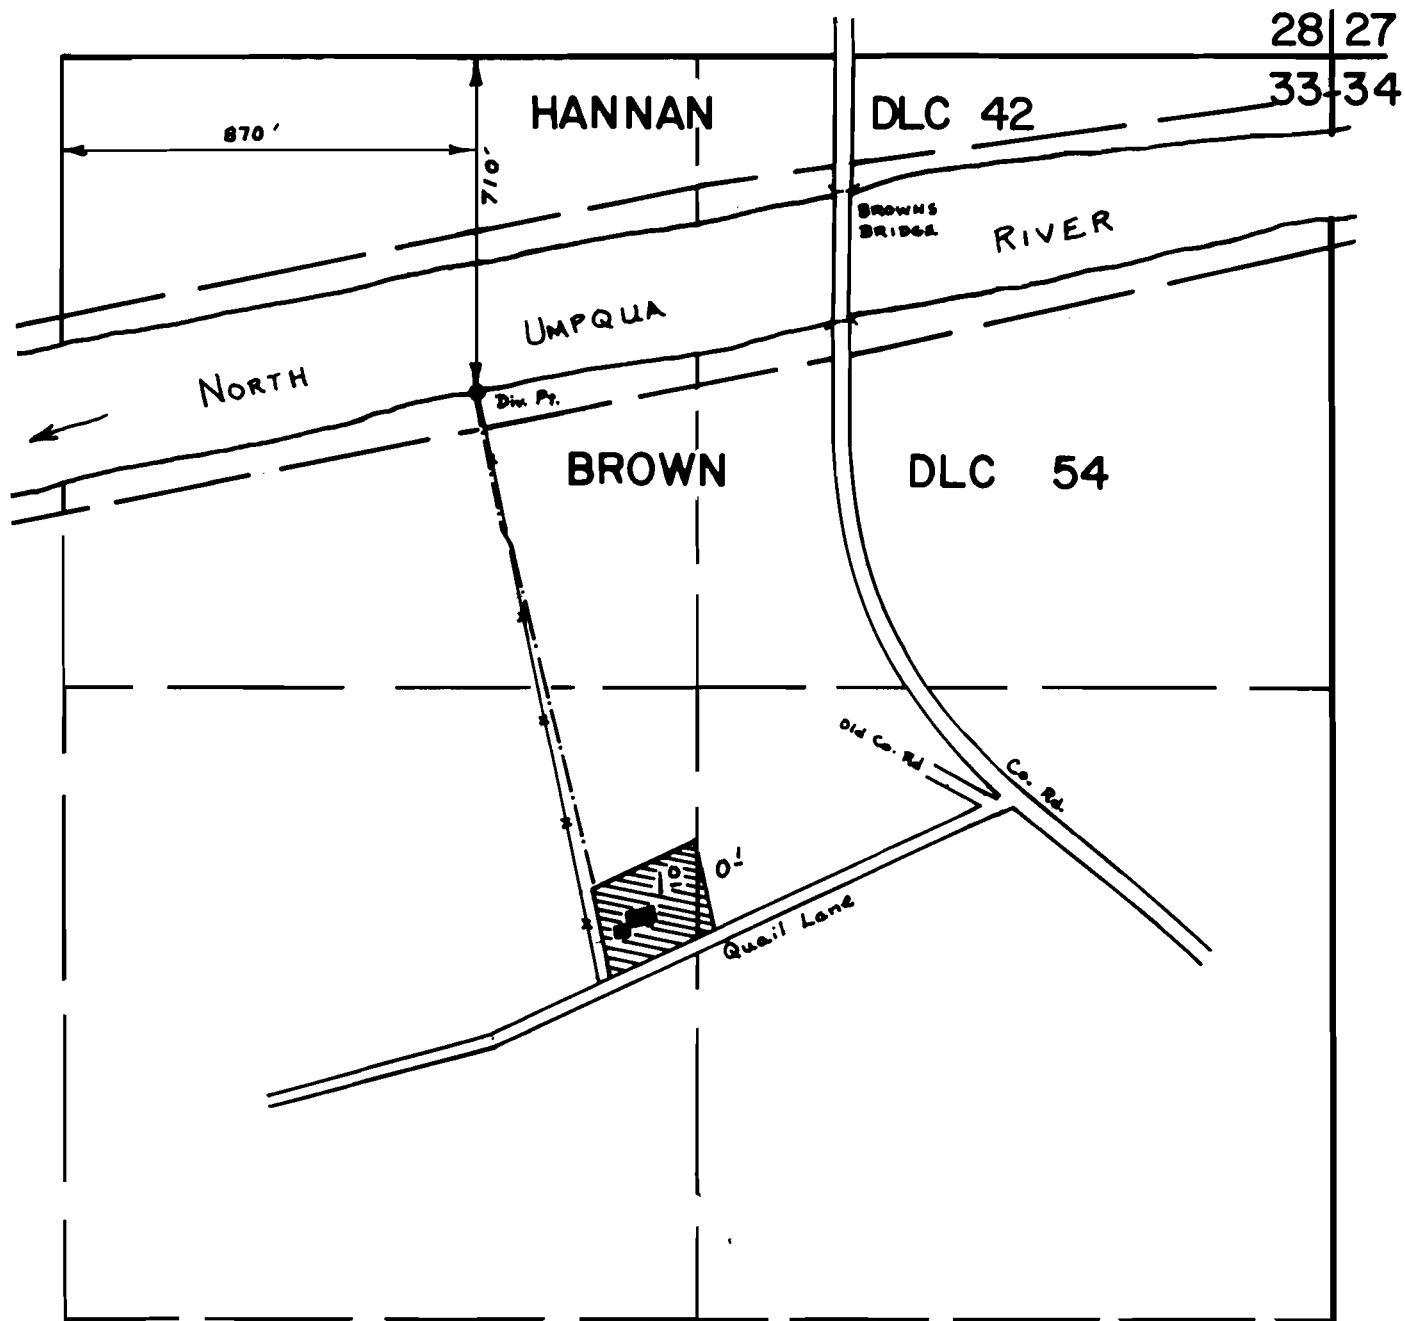

SCALE: 1" = 400'

**FINAL PROOF SURVEY
UNDER**

Application No. 54477 Permit No. 40863
IN NAME OF

FRED G. & VIRGINIA L. PILGER

Surveyed Dec. 13, 1978, by S. Donaldson