T. 29 S., R. 5 W., W.M.

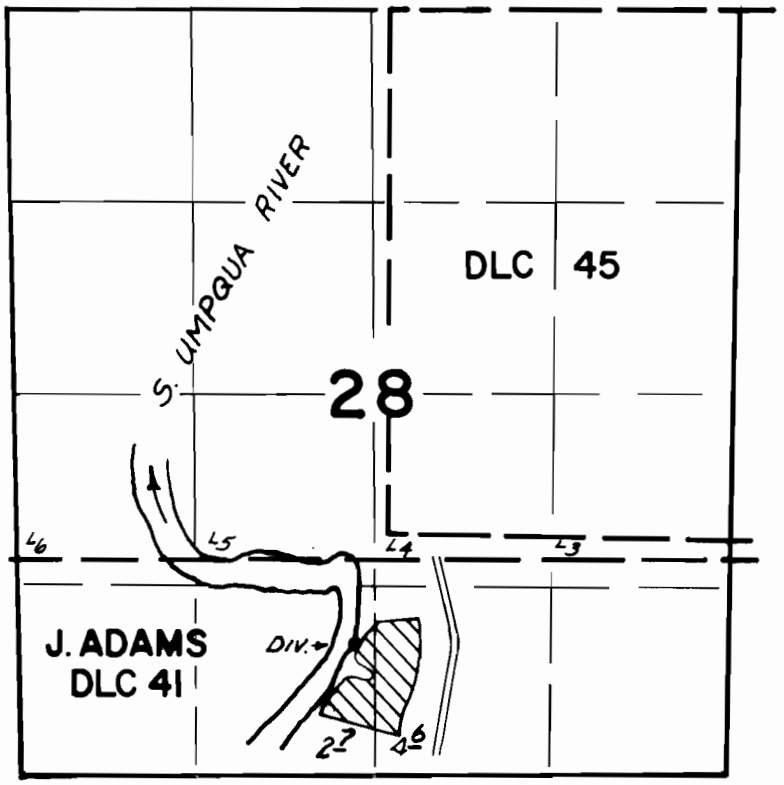

DIV. PT. LOC.: 910' N. & 140' W. FROM S. 1/4 COR. SEC. 28

FINAL PROOF SURVEY
UNDER

Application No. 51116 Permit No. 38641
IN NAME OF

James Jeffries and Julie Gay Jones

Surveyed OCT. 7, 1976, by L. NUNN

BTR-3HH-76 NCB