


T. 26 S., R. 5 W., W.M.

SEC. 21

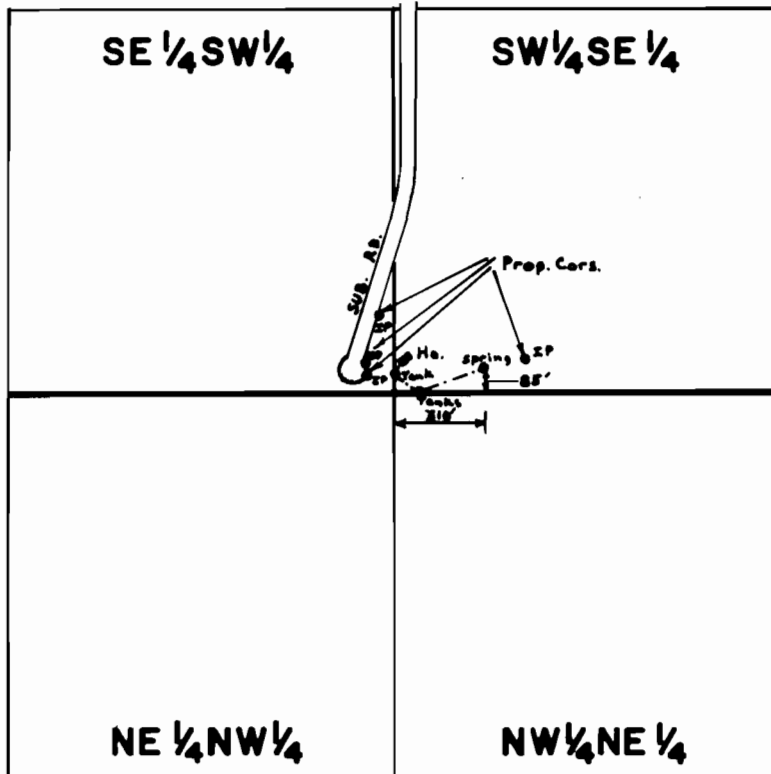

SEC. 28

SCALE: 1" = 660'

FINAL PROOF SURVEY

UNDER

Application No. 52043 Permit No. 39221.....
IN NAME OF

E. W. MONTGOMERY

Surveyed JAN. 30. 1978, by D.W. SPARKS.....