


T.26S. R.6W. W.M.

Sec. 23

NE 1/4 NW 1/4

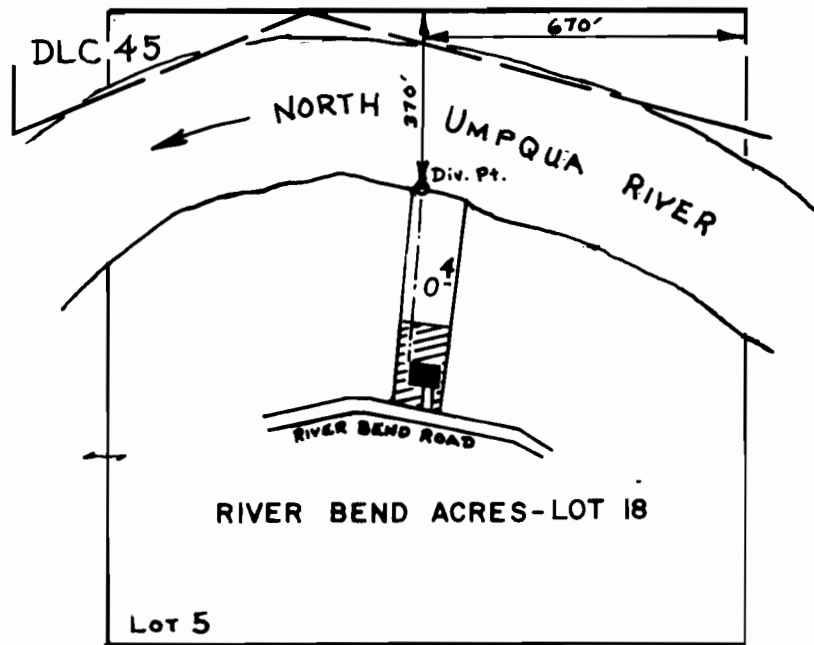

SCALE : 1" = 400'

FINAL PROOF SURVEY
UNDER

Application No. 51133 Permit No. 38651
IN NAME OF

MARGARET M. GEBHARDT

Surveyed Jan. 25 1979, by S. Donaldson