


T. 24 S. R. 5 W. W.M.

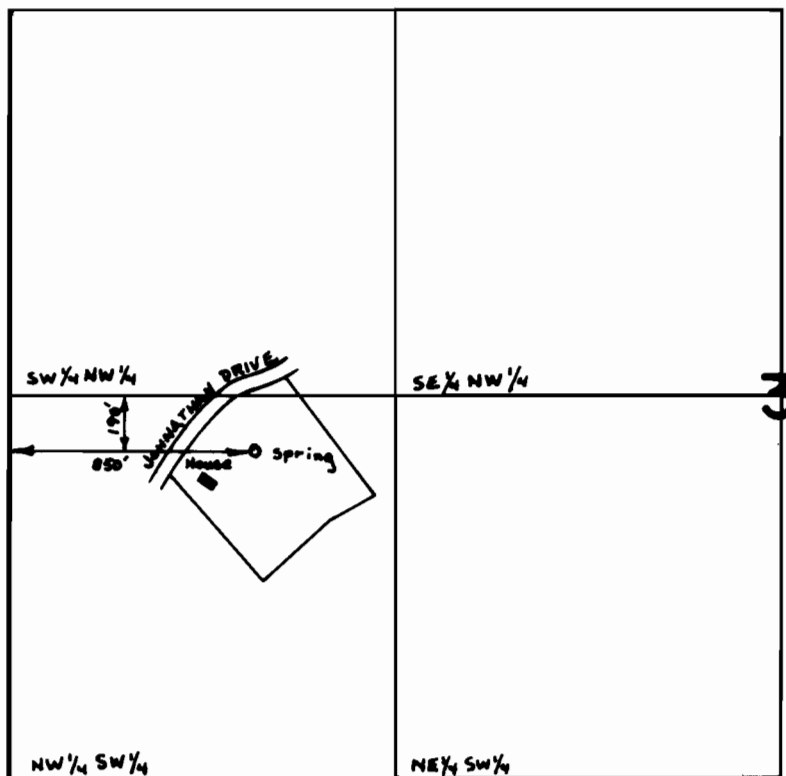

SCALE : 1" = 660'

FINAL PROOF SURVEY
UNDER

Application No. 54615... Permit No. 40980..
IN NAME OF

ROBERT W. & WILMA P. LACY...

Surveyed Nov...3... 1977., by D...Sparks.....