


T.30S. R.5W. W.M.

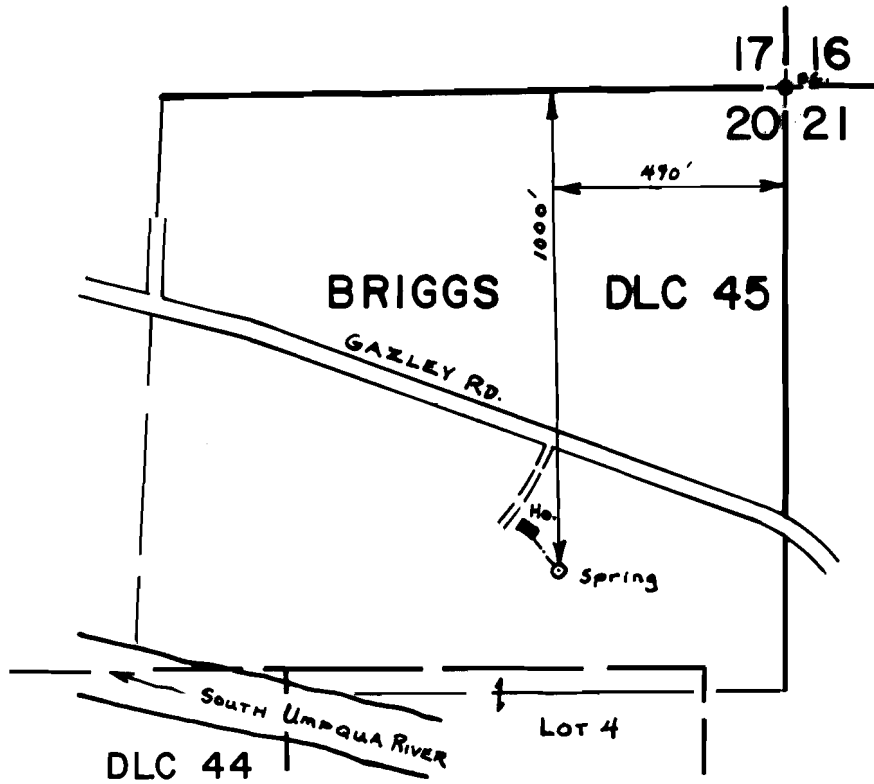

SCALE: 1" = 400'

**FINAL PROOF SURVEY**  
UNDER

Application No. 56826 Permit No. 42815  
IN NAME OF

LOUIS T. SANDERFER

Surveyed July 6, 1978, by D. R. Henry