


T.28S. R.6W. W.M.

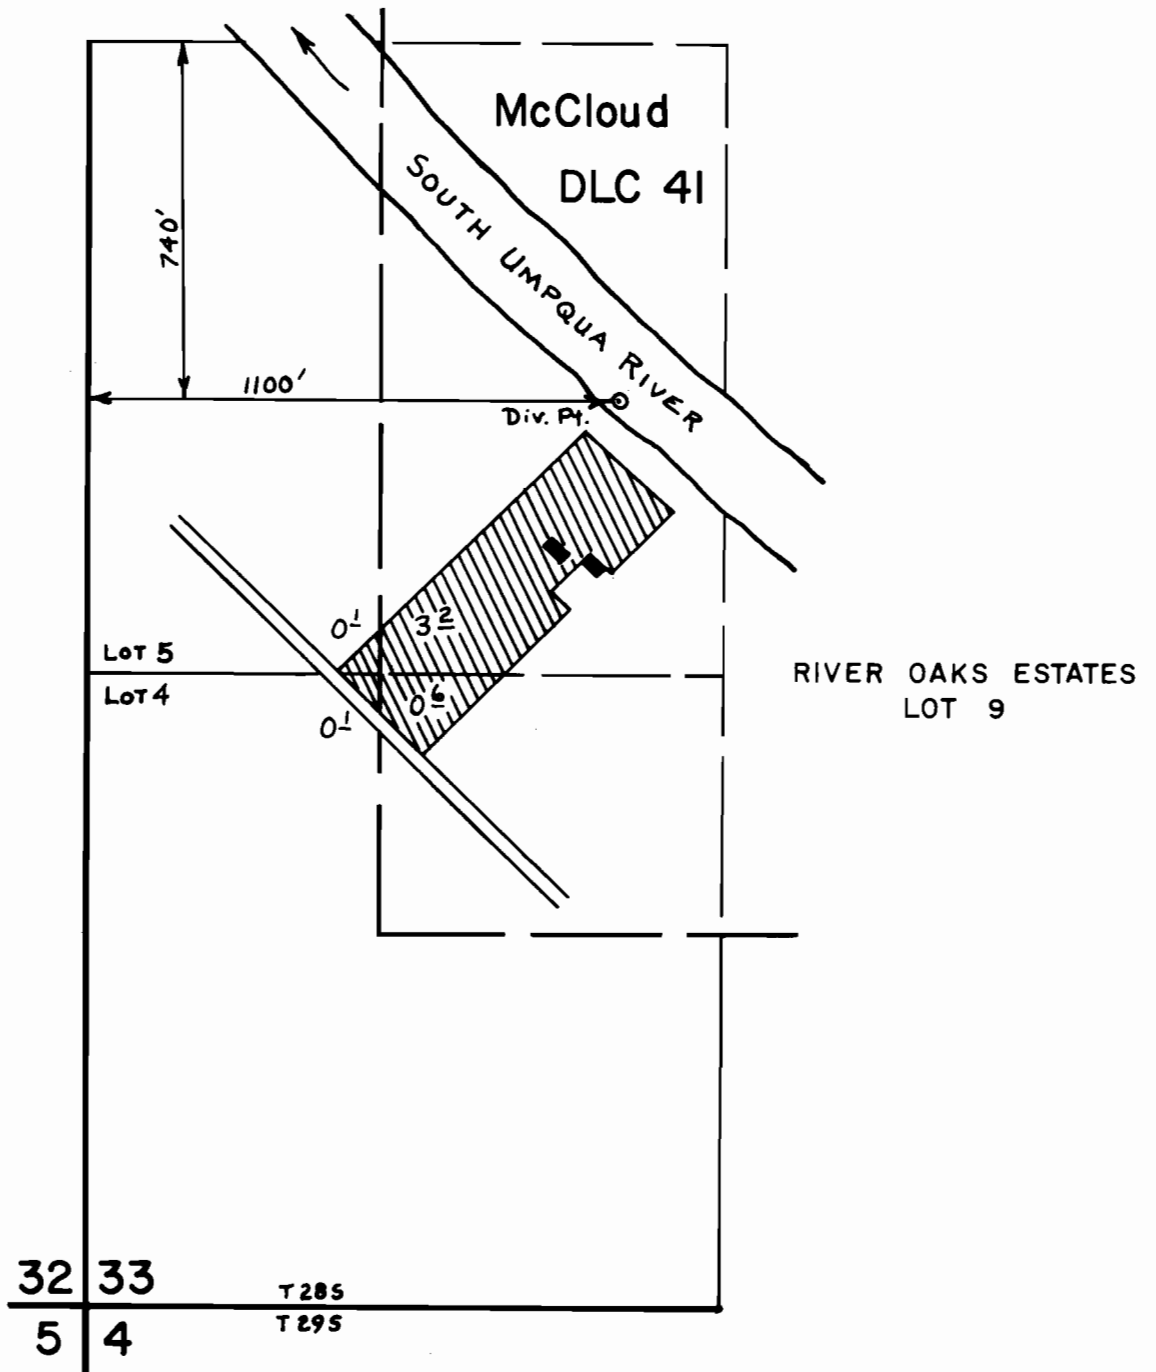

**FINAL PROOF SURVEY**  
UNDER

SCALE: 1" = 400'

Application No. 53671 Permit No. 40130

IN NAME OF

RUTH HILL

Surveyed Aug. 3 1978, by D. Sparks