


T. 25 S., R. 7 & 6 W., W.M.

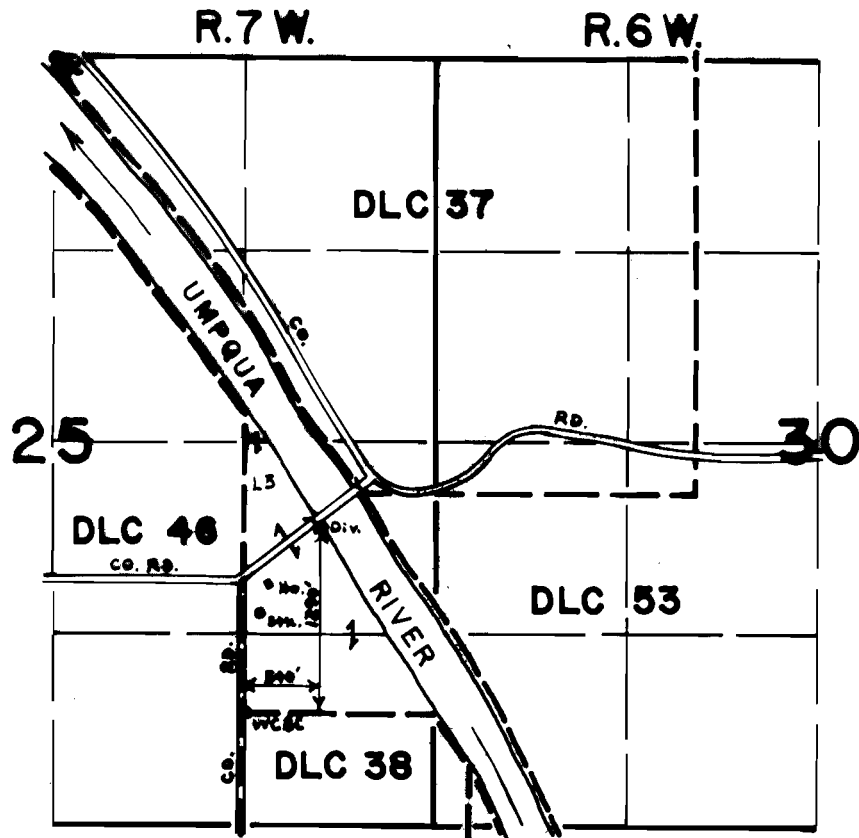

FINAL PROOF SURVEY
UNDER

Application No. 55866... Permit No. 41907...
IN NAME OF

DELMAR MURPHY

Surveyed APR. 27 1978, by D.W. SPARKS.....