T. 24 & 25 S., R. 5 W., W.M.

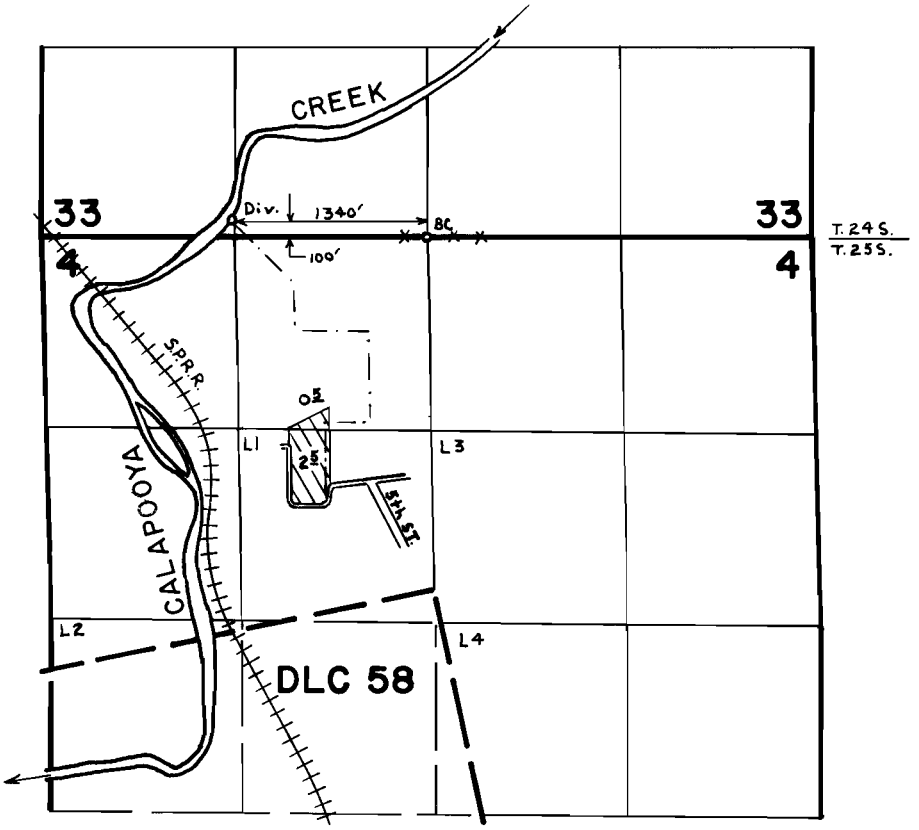

FINAL PROOF SURVEY
UNDER

Application No. 51301 Permit No. 37117
IN NAME OF

OAKLAND SCHOOL DISTRICT NO. 1

Surveyed FEB. 21 1979, by J. S. DONALDSON

72-12-35 D Doug Co. DRH