


T.27S. R.6 W. W.M.

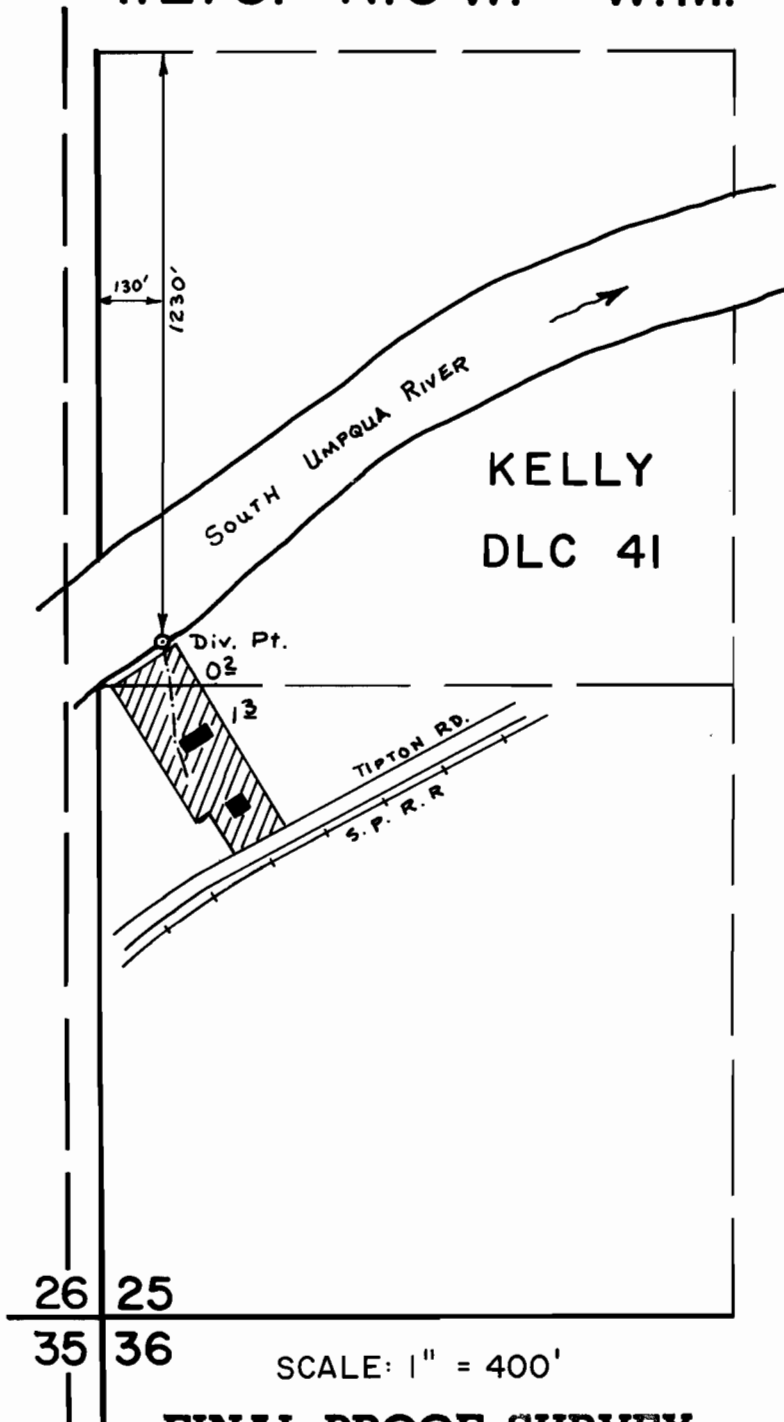

FINAL PROOF SURVEY
UNDER

Application No. 50396 Permit No. 38036
IN NAME OF

Rex F. & Marie L. Garriott

Surveyed July 28 1978, by D. Henry