


T. 29S. R. 8W. W.M..

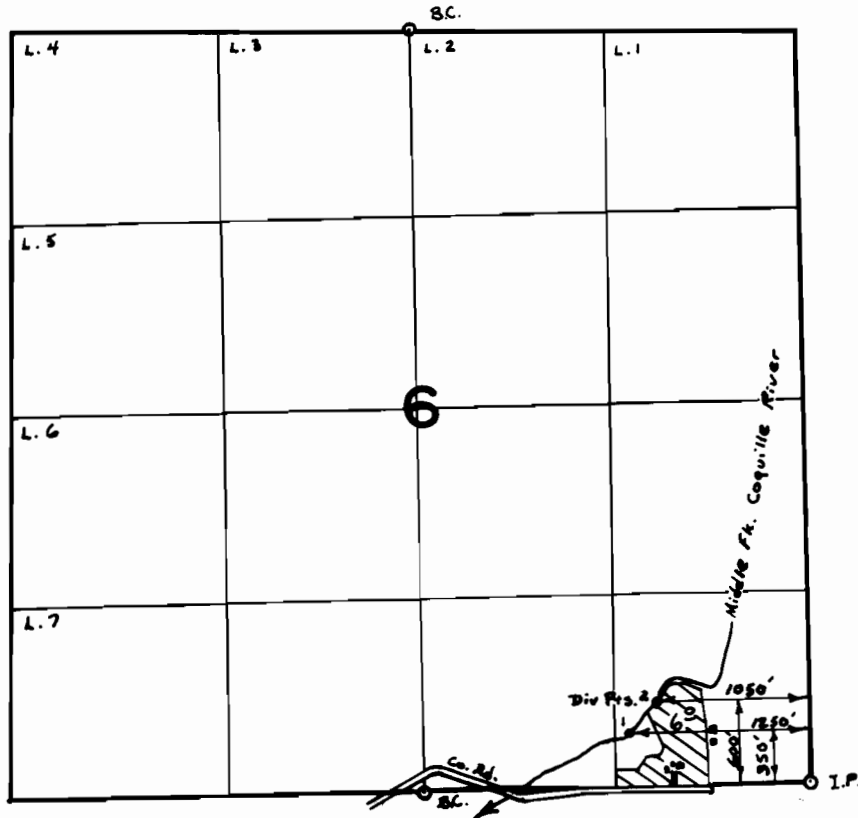

FINAL PROOF SURVEY
UNDER

Application No. 49959 Permit No. 37754
IN NAME OF

STANLEY EDWIN LITTLE

Surveyed OCT. 31 1978, by S. DONALDSON