


# T. 25 S., R. 6 & 5 W., W.M. .

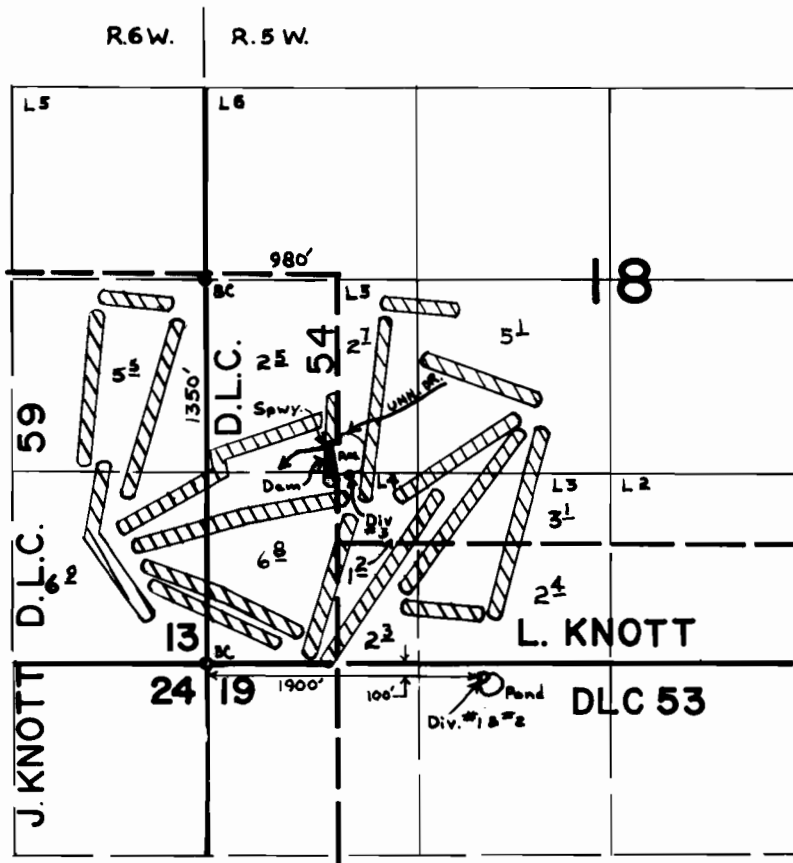

## FINAL PROOF SURVEY UNDER

R-49985                      R-6140  
 Application No. ~~49986~~ Permit No. 37945  
 IN NAME OF

**BUDICK, INC. dba SUTHERLIN KNOLLS**

Surveyed MAR. 17, 1978, by D.W. SPARKS.....