


T. 30 S. R. 5 W. W.M.

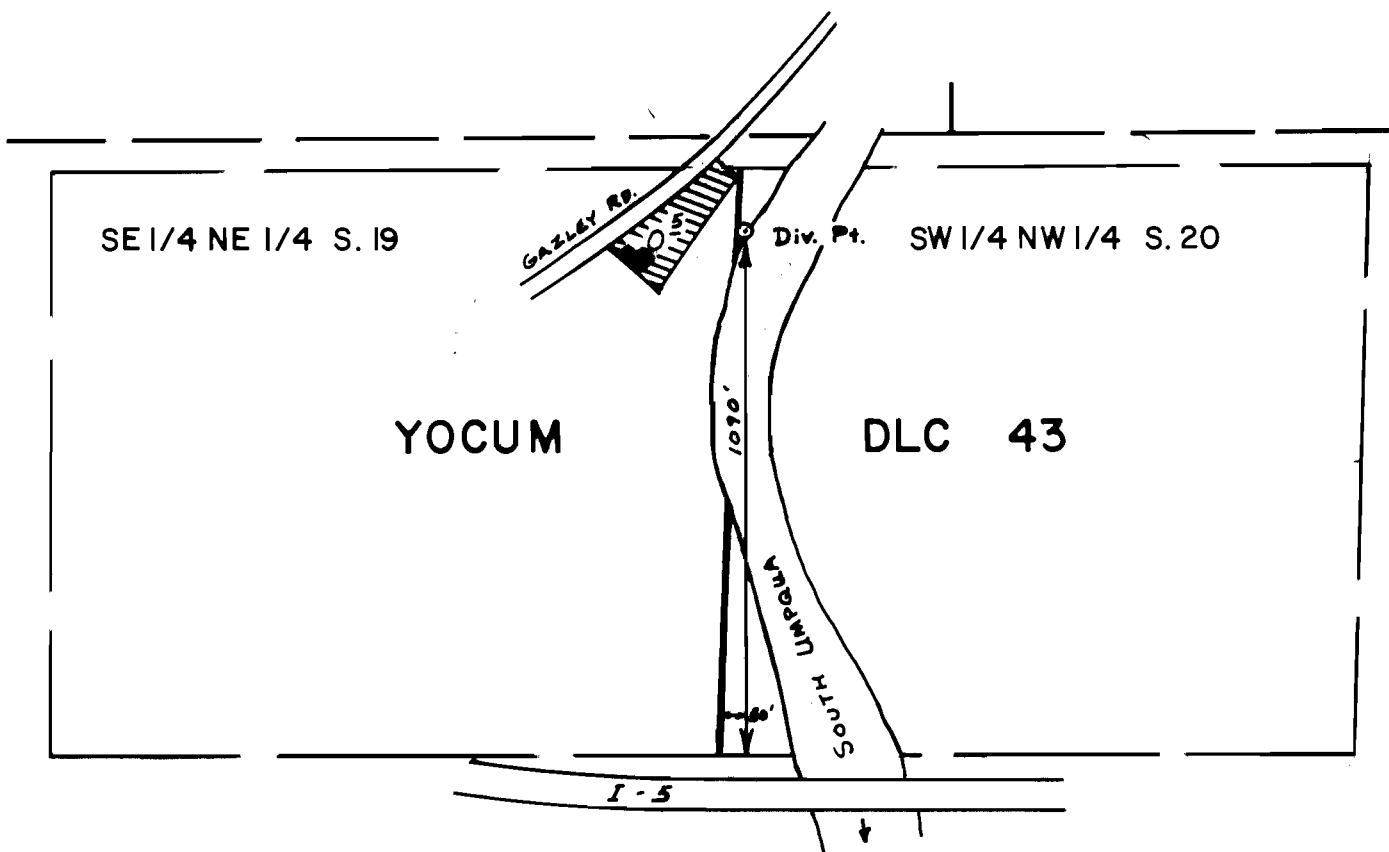

SCALE: 1" = 400'

FINAL PROOF SURVEY
UNDER

Application No. 56773 Permit No. 42584
IN NAME OF

FRED M. & ELEANOR CARPENTER

Surveyed Sept. 28 1978, by D. Henry