


T.38S. R.3W. W.M.

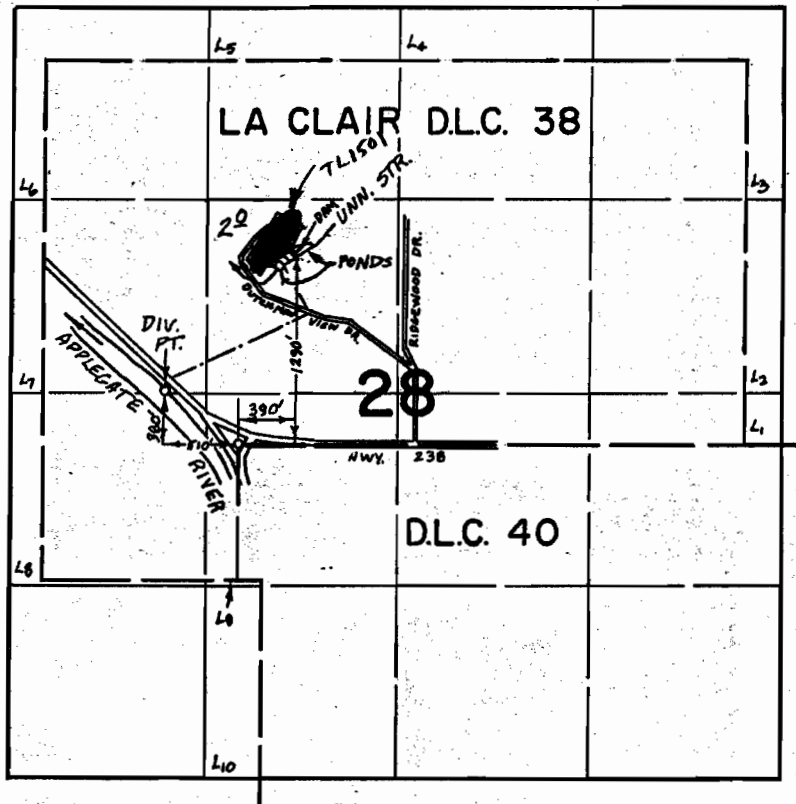

Application: 48226 Permit 36218

~~TL 1524~~  
~~TL 1527~~

~~Mae Russell 310 Ridge Road Dr.~~  
~~Jacksonville, OR. 97530~~

**RECEIVED**

JUN 22 1979

WATER RESOURCES DEPT.  
SALEM, OREGON

TL 1501 - Riess, Margie Ann c/o Rich Realty  
7635 Hwy 238 Jacksonville, OR 97530