


T.9S. R.14E., W.M.

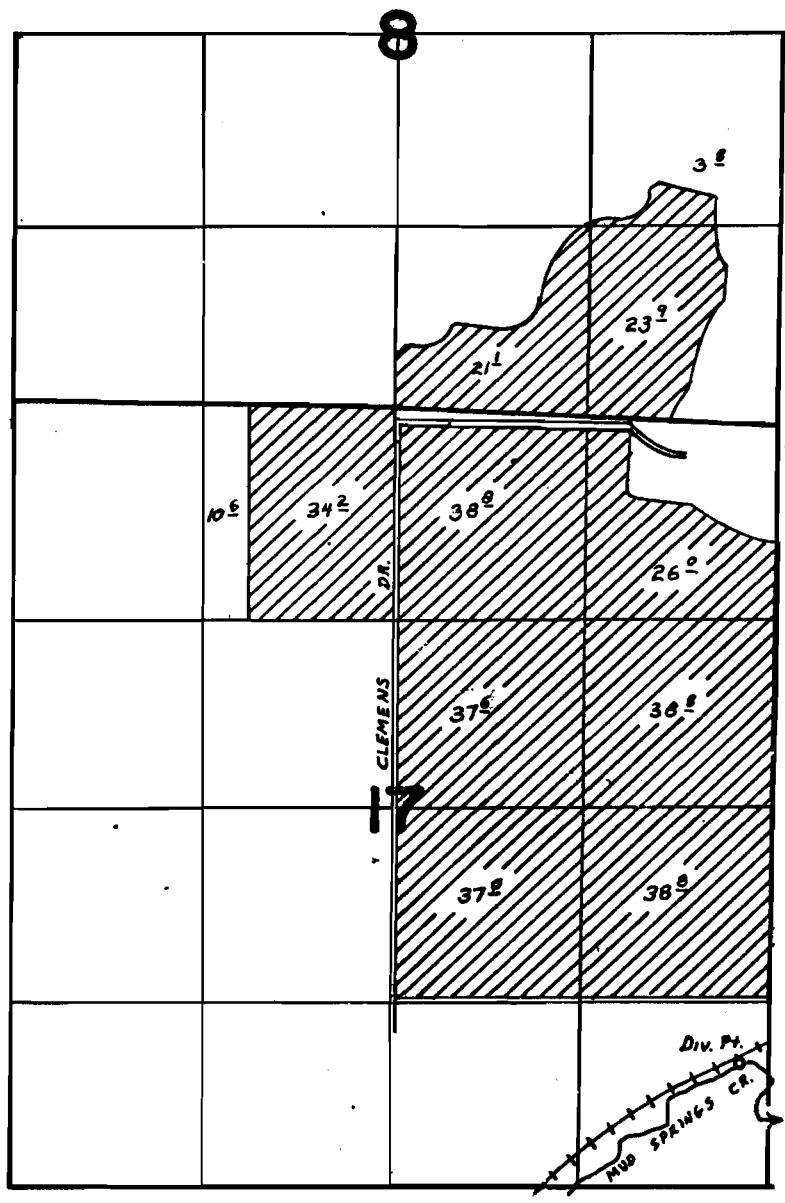

Div. Pt. Loc. 850' N. & 200' W. From S.E. Cor. Sec. 17

FINAL PROOF SURVEY UNDER

Application No. 52550... Permit No. 39650...
IN NAME OF

...JOE G. & BARBARA L. AUSTIN...

Surveyed JUNE 26 1979, by L.H. NUNN.....