


48825  
48826

# T. 9S., R. 16 & 17E., W.M.

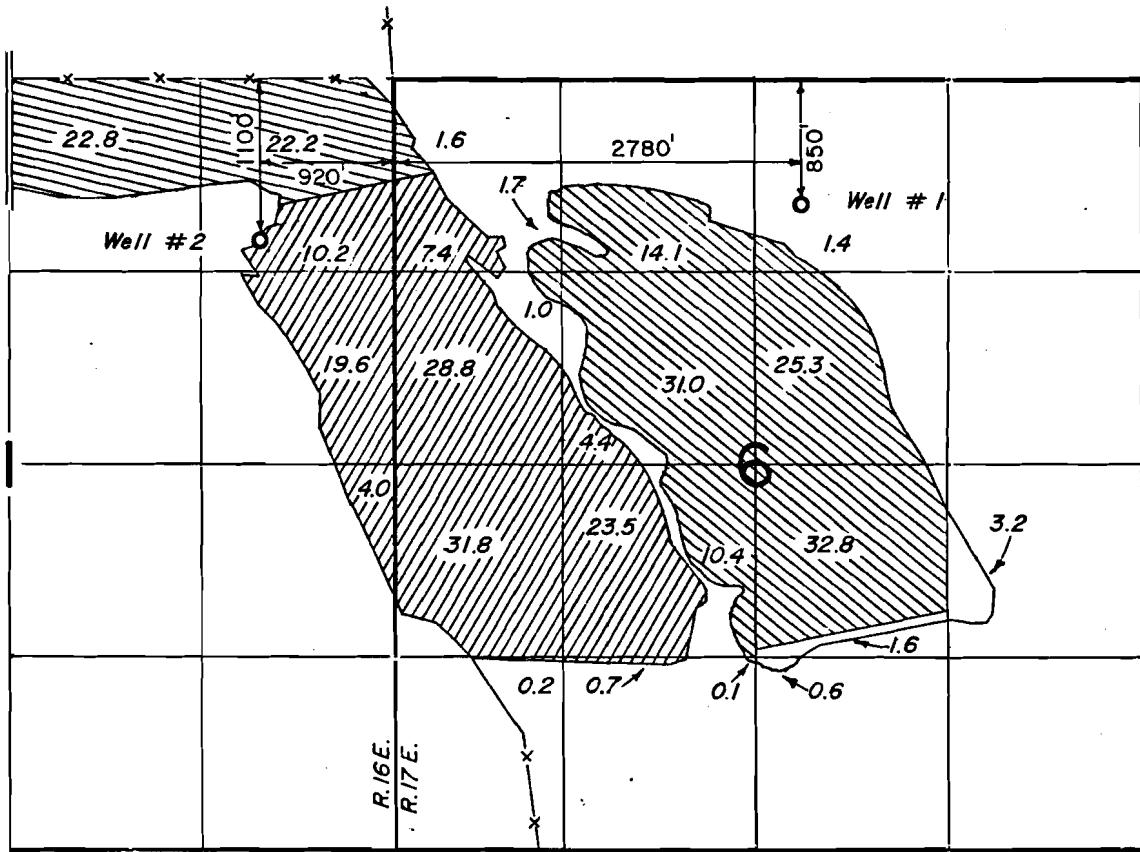

Well No. 2, Permit G-6367; 
  Well No. 1, Permit G-6367; 
  Well No. 1, Permit G-6368

## FINAL PROOF SURVEY UNDER

G-6878                      G-6367 48825  
 Application No. G-6970    Permit No. G-6368 48826  
 IN NAME OF

*Frank McNamee*

Surveyed JUNE 16, 1978, by L. NUNN