


# T.9S. R.14E., W.M.

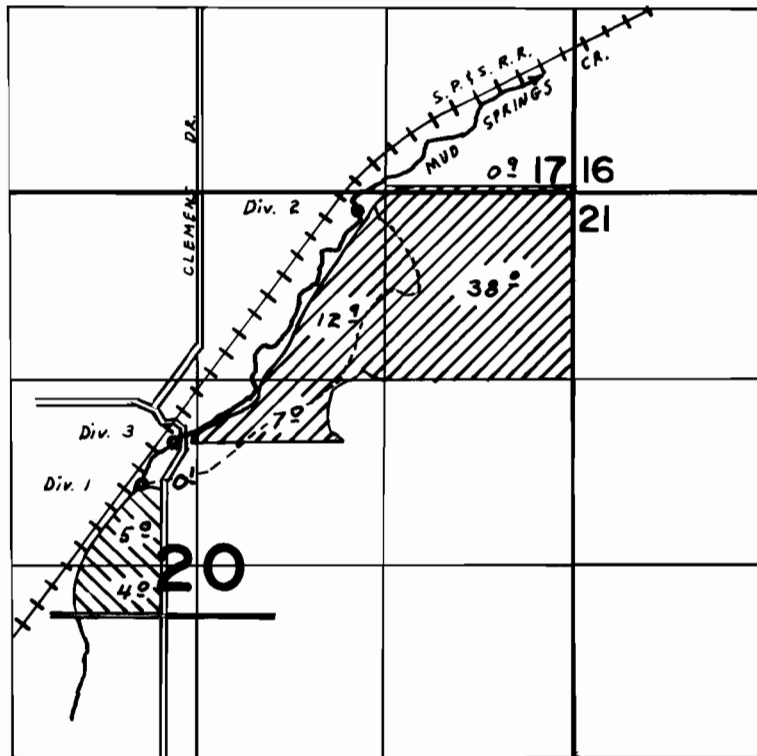

1- 2010'S & 2950'W.  
 Div. Loc.: 2- 130'S. & 1480'W. All From N.E. Cor. Sec. 20  
 3- 1730'S. & 2740'W.

## FINAL PROOF SURVEY UNDER

Application No. 53905... Permit No. 40460...  
 IN NAME OF

.....HEBERT A. VIBBERT.....

Surveyed JUNE 26 1979., by L.H. NUNN.....