


# T.36S., R.5W., W.M.

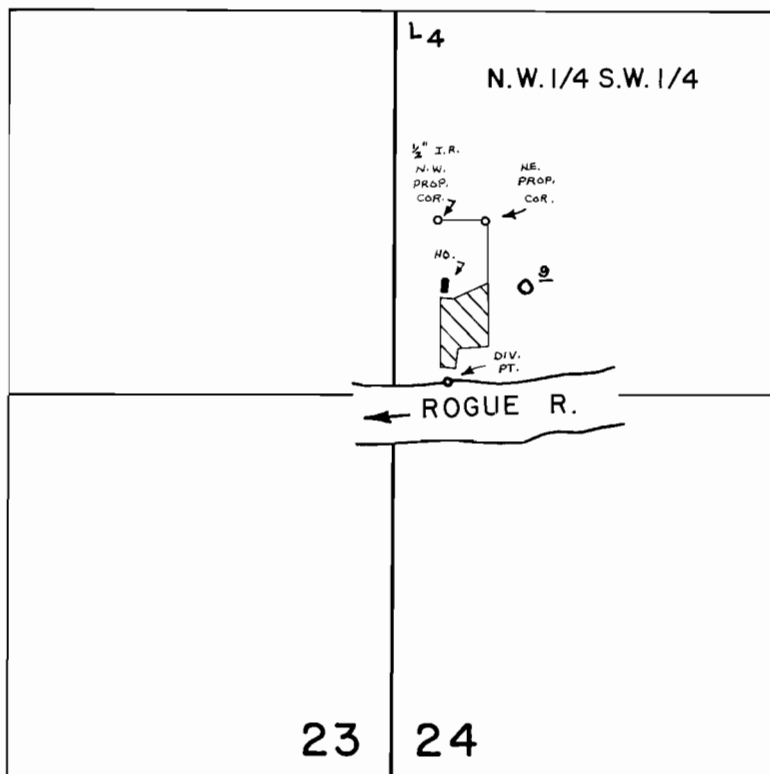

Lot 4

DIV. PT. LOC.: 1270'S. & 180'E. FROM W. 1/4 COR. SEC. 24.

SCALE : 1" = 660'

## FINAL PROOF SURVEY UNDER

Application No. 52411 Permit No. 39422  
IN NAME OF

.....Martin and Lillian Siekerski.....

Surveyed OCT. 7 1977, by B. SUND