


38228  
48829

# T.39S. R.11E. W.M.

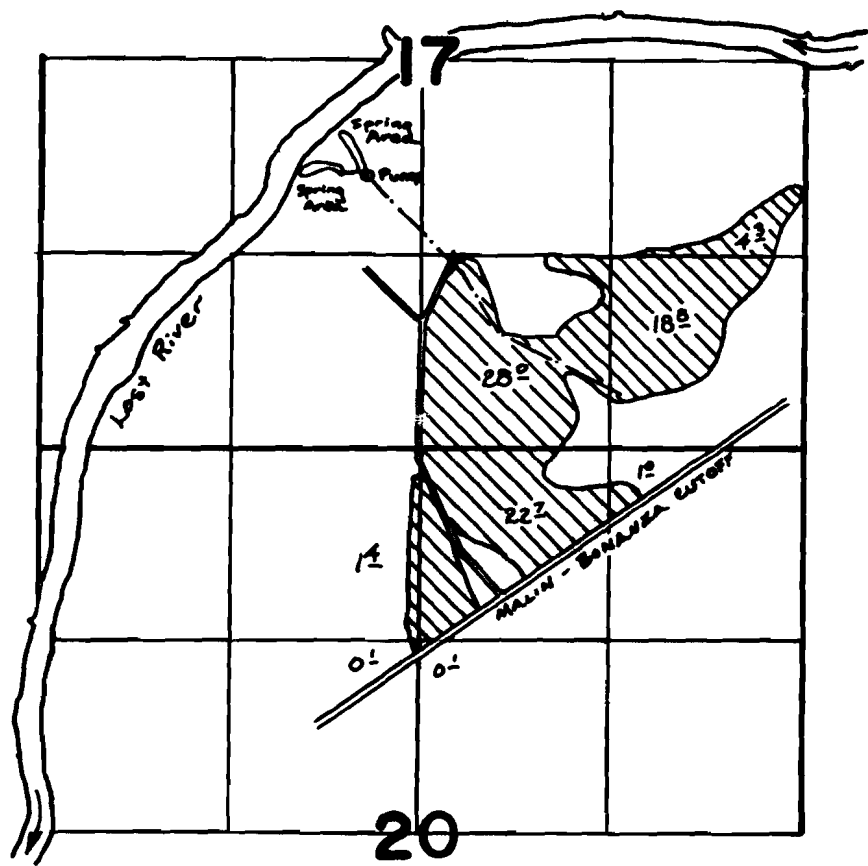

Lost River Meas.

Spring Areas Located 1900' N of 600' W and 2000' N of 450' W  
both from the S/4 cor Sec. 17

## FINAL PROOF SURVEY UNDER

Application No. 52829 Permit No. 38228  
IN NAME OF

KENNETH & JO ANNE CORDIS

Surveyed AUG. 24 1977, by D. NORBY