


T.17S. R.2W. W.M.

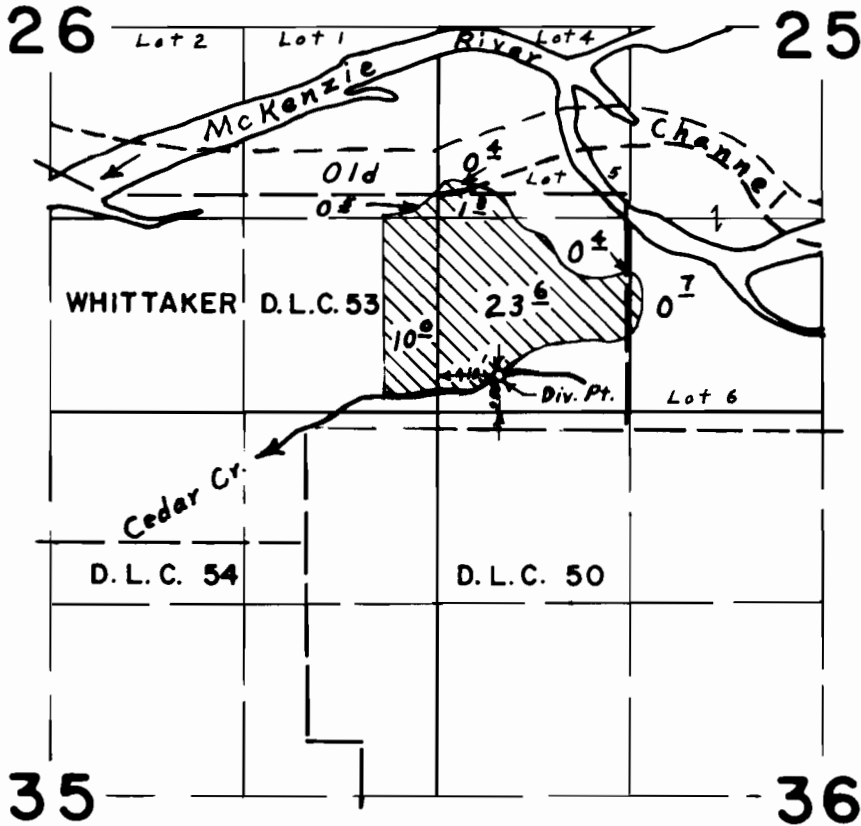

FINAL PROOF SURVEY
UNDER

Application No. 45322. Permit No. 33833
IN NAME OF

Glen O. Dent & Wayne E. Fleek

Surveyed June 22, 1976, by L. E. Gould