


T.9S.,R.1E.,W.M.

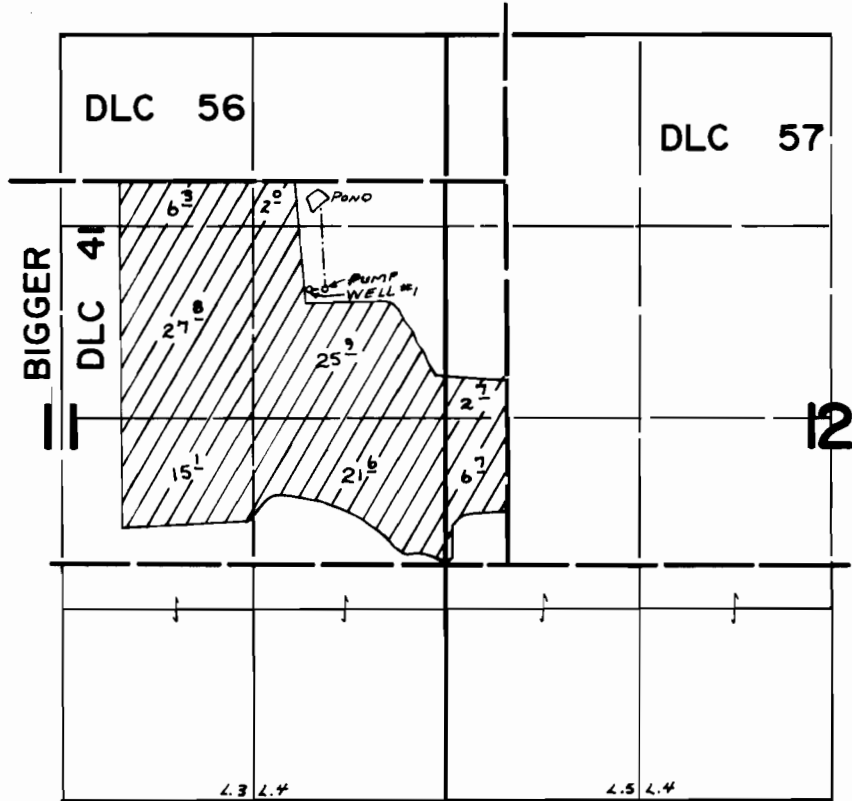

WELL #1 LOC: 740'S AND 1360' W FROM NE COR BIGGER DLC #41

FINAL PROOF SURVEY UNDER

Application No. G-5771 Permit No. G-5549
IN NAME OF

DONALD C. & LUELLE M. NIELSON

Surveyed July 9, 1976, by L. TOLL