


T. 7S. R. 1W. W.M.

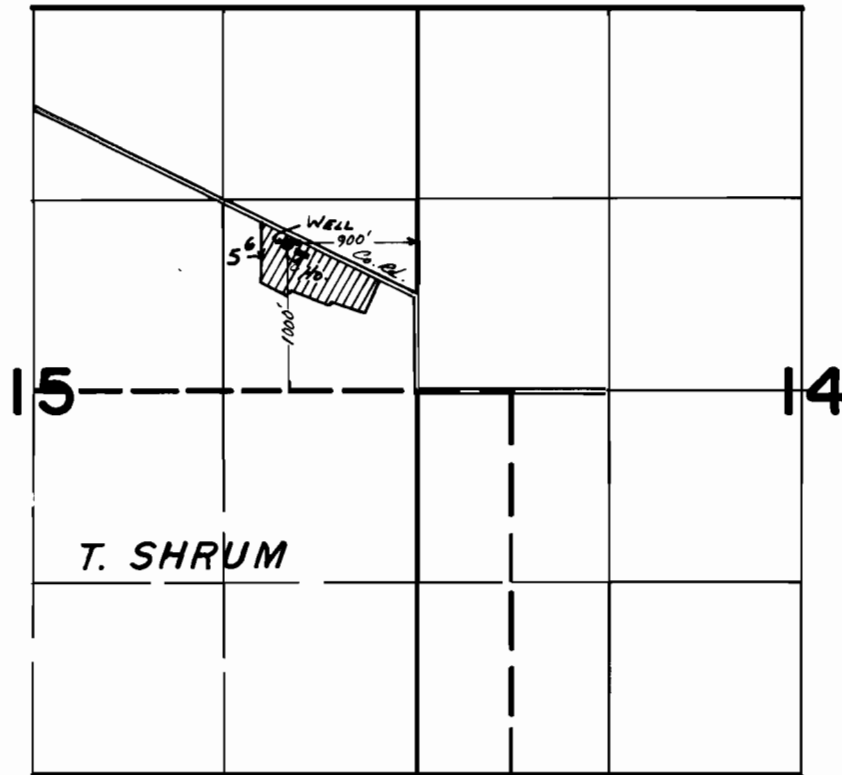

FINAL PROOF SURVEY UNDER

Application No. G-7462 Permit No. G-6951
IN NAME OF

ROLAND A. BOLLIGER

Surveyed July 3 1978, by R.G. Mucken