


T. 2 N., R. 12 E., W., W.M.

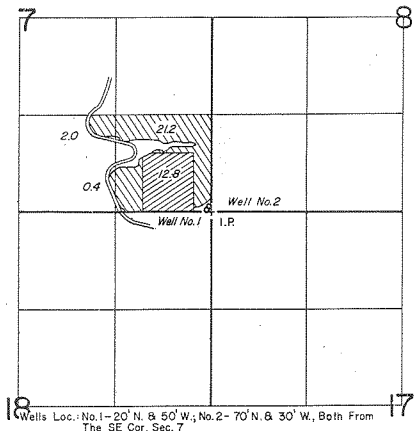

FINAL PROOF SURVEY
UNDER

Application No. G-5353 Permit No. G-5249
G-8122 G-7499
IN NAME OF

BRUCE D. ECCLES

Surveyed MAR. 30, 1978, by L. NUNN

RECEIVED
JAN 21 1980
REGISTERED