


T. 2 N., R. 12 E., W. W.M.

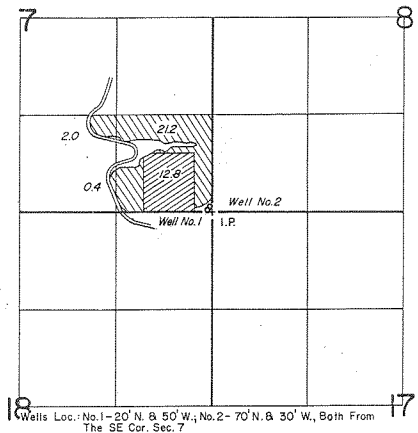

FINAL PROOF SURVEY UNDER

Application No. G-5353 Permit No. G-5249
G-8122 G-7499

IN NAME OF
BRUCE D. ECCLES

Surveyed MAR. 30, 1978, by L. NUNN.....

RECEIVED
 JAN 21 1980
 RECEIVED