


# T.I.N. & I.S.R. 2 W.W.M.

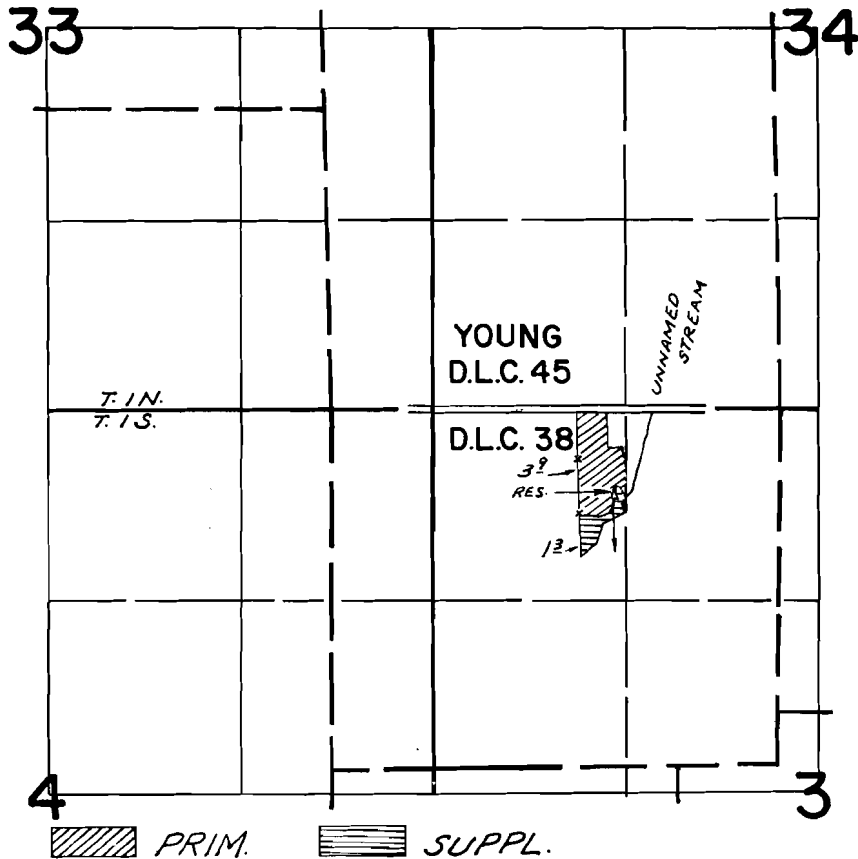

DIV. LOC: 620' S. & 1250' E. FROM N.W. COR. SEC. 3

## FINAL PROOF SURVEY UNDER

Application No. ~~57175~~ <sup>R-50930</sup> Permit No. ~~42899~~ <sup>R-7022</sup>  
IN NAME OF

.....KENNETH W. SMITH.....

Surveyed JUNE 26, 1978, by S.P. APPLGATE