


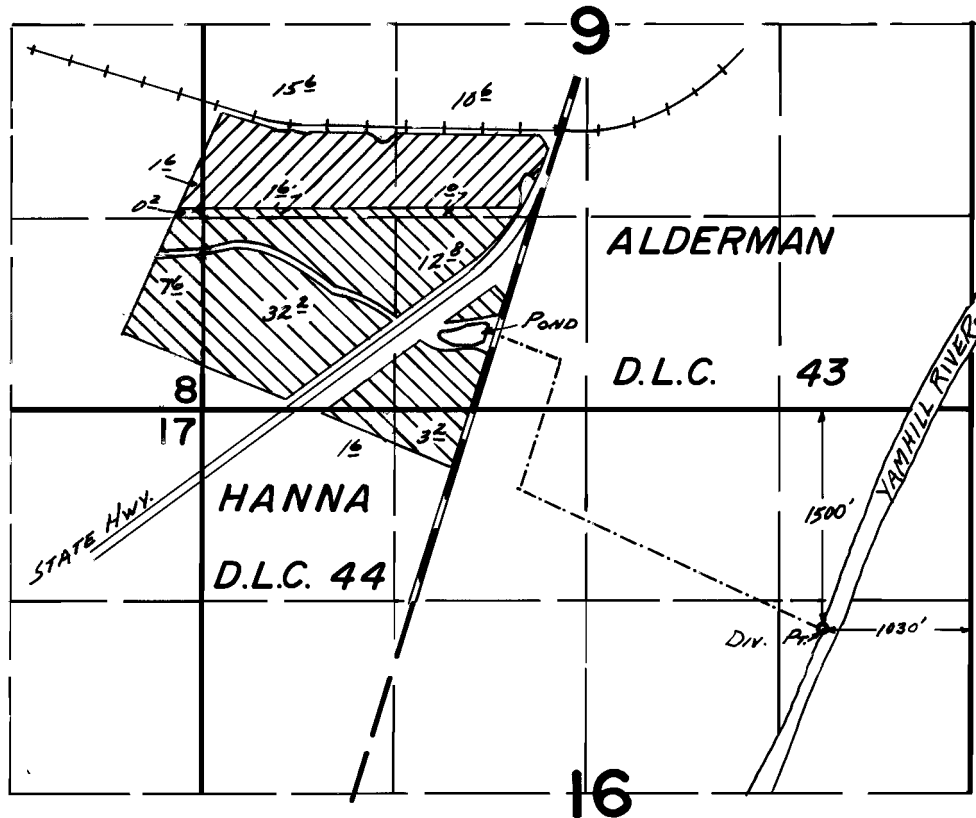

T. 4S. R. 3W. W.M.



 - APP # 55304
 - TR. No. 3540

FINAL PROOF SURVEY UNDER

Transfer No. 3540
Application No. 55304 Permit No. 41483...
IN NAME OF

PHILLIP A. HAWMAN

Surveyed March 15 1978, by L.H. Nunn