


T.9S.,R.3W.,W.M.

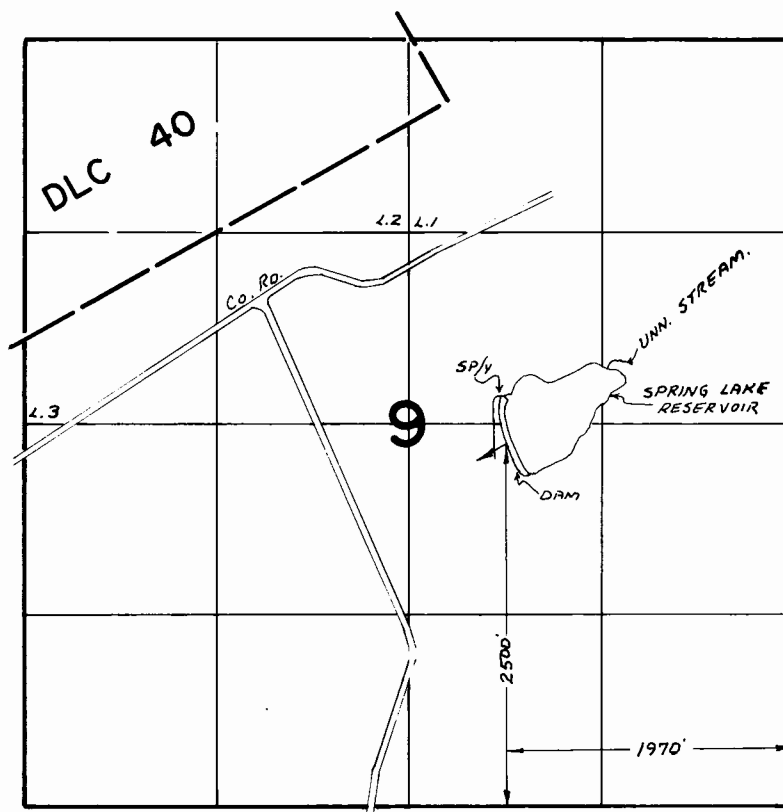

FINAL PROOF SURVEY
UNDER

R-49845 R-5869
Application No. 49846 Permit No. 36244
IN NAME OF
SPRING LAKE ESTATES
RECREATION PROPERTY, INC.

Surveyed July 6, 1976, by L. Toll