


T.8S., R39E., W.M.

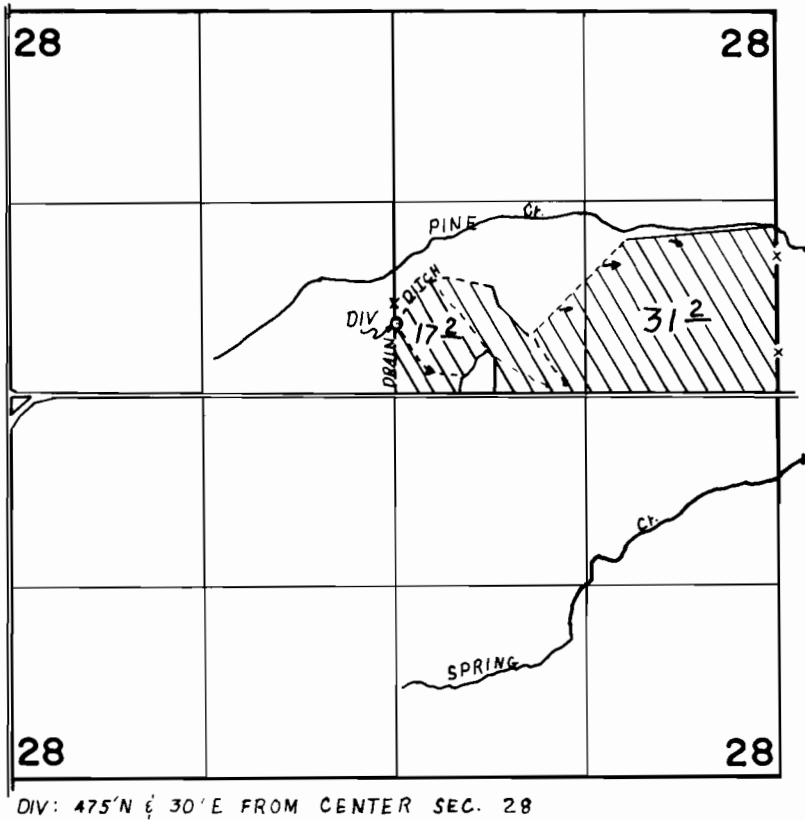

FINAL PROOF SURVEY

UNDER

Application No. 51600 Permit No. 38921
IN NAME OF

WALLACE SIMRELL

Surveyed JUNE 24, 1976, by C.R. KING.....